

MISSISSIPPI DEPARTMENT OF NATURAL RESOURCES

Bureau of Land and Water Resources

Southport Mall

P.O. Box 10631

Jackson, Mississippi 39209

WATER WELL DRILLERS LOG

PEARL RIVER
 02086

5-21-85 date well completed WALKERS WELDING firm name P.R. county well located

LANDOWNER: SOLLIE SMITH
RT. 1

CARRIERE
 (mailing address)

WELL LOCATION:
 sec. 22 T 4 S R. 18 W
11 miles W MENEIL
 (distance) (direction) (nearest town)

WELL PURPOSE: HOME
 (home, irrigation, municipal, industrial)


WELL COMPLETION DATA:

- (1) diameter (inches) 4
- (2) total depth (feet) 192
- (3) static water level (feet) 105 below top of ground.
- (4) casing PVC 182
 (material) (depth)
 If telescope see back.
 (size)
- (5) screen 10 182
 (length) (depth to top)
4 PVC
 (size) (material)
- (6) pump 1/2 11
 (HP) (yield gpm)
ELEC.
 (type power)
- (7) electric log
 (yes or no)

 (organization running log)
- (8) how well bottom plugged SAND SHARP

description of formations encountered	from	to
CLAY	0	17
SAND	17	31
CLAY	31	37
SAND & GRAVEL	37	64
CLAY	64	158
SAND	158	163
CLAY	163	167
SAND	167	192

DRILLERS REMARKS:

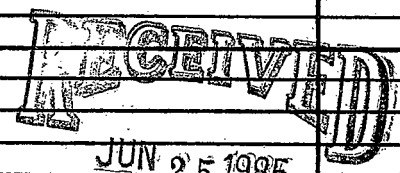

JUN 25 1985

Department of Natural Resources
 Bureau of Land & Water Resources

