

MISSISSIPPI DEPARTMENT OF NATURAL RESOURCES

Bureau of Land and Water Resources

Southport Mall

P.O. Box 10631

Jackson, Mississippi 39209

WATER WELL DRILLERS LOG

PEARL RIVER
Q 2087

6-5 19 85 WALKERS WELDING PR
date well completed firm name county well located

LANDOWNER: JOHN VANHASSEL

RT. 1

CARRIERE MS
(mailing address)

WELL LOCATION:

sec. 26 T. 4 S. R. 18 E. W.
1.2 miles 30 of CARRIERE
(distance) (direction) (nearest town)

WELL PURPOSE: HOME
(home, irrigation, municipal, industrial)

WELL COMPLETION DATA:

- (1) diameter (inches) 4
- (2) total depth (feet) 87
- (3) static water level (feet) 54 below above top of ground.
- (4) casing PVC 87
(material) (depth)
(size) if telescope see back.
- (5) screen 10' 77
(length) (depth to top)
(size) (material)
- (6) pump 1/2 12
(HP) (yield gpm)
ELECTRIC
(type power)
- (7) electric log _____
(yes or no)
(organization running log)
- (8) how well bottom plugged sand shark

description of formations encountered	from to	
	ft	ft
CLAY	0	17
SAND	17	29
CLAY	29	36
SAND	36	47
CLAY	47	55
SAND	55	87


DRILLERS REMARKS:

RECEIVED
JUN 25 1985

Department of Natural Resources
Bureau of Land & Water Resources

If well telescopes please sketch and show depths.

GROUND LEVEL

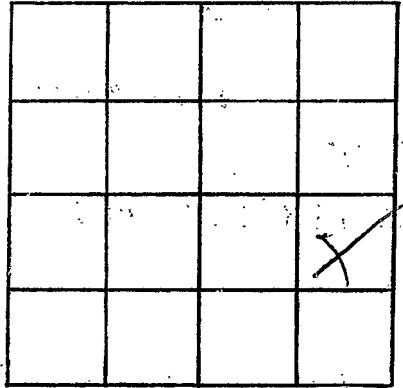

SECTION _____

Please indicate well location X.

ADDITIONAL INFORMATION

If more than one screen,
show locations of each on sketch.