

MISSISSIPPI DEPARTMENT OF NATURAL RESOURCES
Bureau of Land and Water Resources
 Southport Mall
 P.O. Box 10631
 Jackson, Mississippi 39209
WATER WELL DRILLERS LOG

Pearl River
02088
7-17-85

7-17-85 date well completed WALKERS WEEDING firm name PR. county well located

LANDOWNER: REGINA THOMAS
RT. 1
CARRIERE MS.
 (mailing address)

description of formations encountered	from	to
CLAY		
CLAY	0	19
SAND	19	34
CLAY	34	41
SAND	41	92

WELL LOCATION:
 sec. 26 T. 4 N. R. 18 W.
S W
13 miles NW of PIRAYANE
 (distance) (direction) (nearest town)

WELL PURPOSE: HOME
 (home, irrigation, municipal, industrial)

WELL COMPLETION DATA:

- (1) diameter (inches) 2"
- (2) total depth (feet) 92
- (3) static water level (feet) 30 below top of ground.
- (4) casing PVC, 92
 (material) (depth)
 (size) If telescope see back.
- (5) screen 10', 82
 (length) (depth to top)
2", PVC
 (size) (material)
- (6) pump 1', 10
 (HP) (yield gpm)
GLEE
 (type power)
- (7) electric log
 (yes or no)
 (organization running log)
- (8) how well bottom plugged Sand shot

RECEIVED


JUL 19 1985

DRILLERS REMARKS:

Department of Natural Resources
 Bureau of Land & Water Resources

If well telescopes please sketch and show depths.

GROUND LEVEL

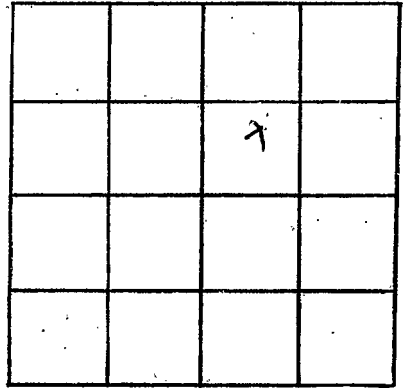

SECTION _____

Please indicate well location X.

ADDITIONAL INFORMATION

If more than one screen,
show locations of each on sketch.