

MISSISSIPPI DEPARTMENT OF NATURAL RESOURCES

Bureau of Land and Water Resources

Southport Mall

P.O. Box 10631

Jackson, Mississippi 39209

WATER WELL DRILLERS LOG

Pearl River
02089

Oct 12

date well completed

1985 Walters Welding Pearl River

firm name

county well located

LANDOWNER: R. Jone

description of formations encountered

from

to

R 1 Columbia Miss
Hambyfield
 (mailing address)

<u>Red Clay</u>	<u>0</u>	<u>48</u>
<u>Sand</u>	<u>48</u>	<u>58</u>
<u>Blue Clay</u>	<u>58</u>	<u>126</u>
<u>Sand</u>	<u>126</u>	<u>151</u>
<u>Blue shale</u>	<u>151</u>	<u>205</u>
<u>Sand/air rocks</u>	<u>205</u>	<u>265</u>

WELL LOCATION:

sec. 1 T 4 N S R 18 E W
15 miles NW of Prague
 (distance) (direction) (nearest town)

WELL PURPOSE: Home
 (home, irrigation, municipal, industrial)

WELL COMPLETION DATA: ODTC

(1) diameter (inches) 4 1/2"

(2) total depth (feet) 265'

(3) static water level (feet) 165 below above top of ground.

(4) casing PVC, 250'
 (material) (depth)

4x2 if telescope see back.
 (size)

(5) screen 15', 250
 (length) (depth to top)

8, PVC
 (size) (material)

(6) pump 1 10
 (HP) (yield gpm)

Elec
 (type power)

(7) electric log
 (yes or no)

(organization running log)

(8) how well bottom plugged Spud
Shuck

RECEIVED

NOV - 7 1985

Department of Natural Resources
 Bureau of Land & Water Resources


DRILLERS REMARKS:

If well telescopes please sketch and show depths.

GROUND LEVEL



If more than one screen, show locations of each on sketch.

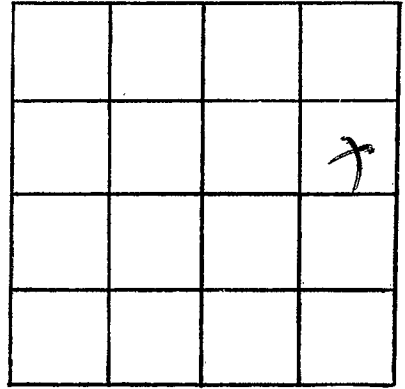

SECTION _____

Please indicate well location X.

ADDITIONAL INFORMATION

Lined area for providing additional information, consisting of 18 horizontal lines.