

MISSISSIPPI DEPARTMENT OF NATURAL RESOURCES

Bureau of Land and Water Resources

Southport Mall

P.O. Box 10631

Jackson, Mississippi 39209

WATER WELL DRILLERS LOG

Pearl River
0 2090

Sept 30

1985 Welton Welding Pearl River

Pearl River

date well completed

firm name

county well located

LANDOWNER: Stanley Hodges
Rout 4 Box 687
Dorham Springs La
 (mailing address)

description of formations encountered

from

to

<u>Red Clay</u>	<u>0</u>	<u>38</u>
<u>Sand</u>	<u>38</u>	<u>45</u>
<u>Blue Clay</u>	<u>45</u>	<u>198</u>
<u>Sand</u>	<u>198</u>	<u>236</u>

WELL LOCATION:

sec. 1 T 4 S R 18 E
 (distance) (direction) (nearest town)

WELL PURPOSE: HOME
 (home, irrigation, municipal, industrial)

WELL COMPLETION DATA: Sept 30

(1) diameter (inches) 4"
 (2) total depth (feet) 236'
 (3) static water level (feet) 165 below top of ground.

(4) casing PVC, 126
 (material) (depth)

(5) screen 10', 126
 (length) (depth to top)

(6) pump NO
 (HP) (yield gpm)

(7) electric log (yes or no)

(8) how well bottom plugged Sand
Block

RECEIVED


NOV -1 1985

DRILLERS REMARKS:

Department of Natural Resources
 Bureau of Land & Water Resources

If well telescopes please
sketch and show depths.

GROUND LEVEL

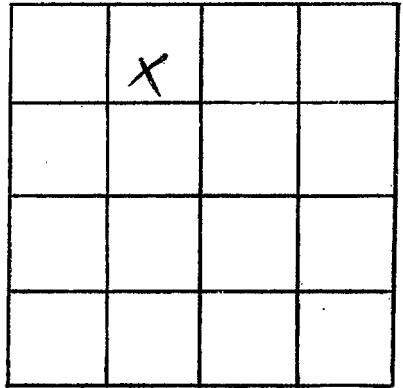

SECTION _____

Please indicate well location X.

ADDITIONAL INFORMATION

If more than one screen,
show locations of each on sketch.