

MISSISSIPPI DEPARTMENT OF NATURAL RESOURCES

Bureau of Land and Water Resources

Southport Mall

P.O. Box 10631

Jackson, Mississippi 39209

WATER WELL DRILLERS LOG

PEARL RIVER
Q 2091

Oct 15 1985 Wallace Welding Pearl River
 date well completed firm name county well located

LANDOWNER: Monte Smith
R1 Carnine Miss
Henlefield
 (mailing address)

description of formations encountered	from	to
<u>Red clay</u>	<u>0</u>	<u>32</u>
<u>Sand</u>	<u>32</u>	<u>48</u>

WELL LOCATION:
 sec. 14 T. 4 N. R. 18 E.
15 miles NW of Plaquemine
 (distance) (direction) (nearest town)

WELL PURPOSE: Home
 (home, irrigation, municipal, industrial)

WELL COMPLETION DATA:

(1) diameter (inches) 2"

(2) total depth (feet) 48

(3) static water level (feet) 30 below top of ground.

(4) casing PVC 38'
 (material) (depth)
 (size) if telescope see back.

(5) screen 10 38'
 (length) (depth to top)
10 PVC
 (size) (material)

(6) pump 1 8
 (HP) (yield gpm)
Elco
 (type power)

(7) electric log (yes or no) _____
 (organization running log) _____

(8) how well bottom plugged Long
shank

RECEIVED


NOV - 1 1985

Department of Natural Resources
 Bureau of Land & Water Resources

DRILLERS REMARKS: _____

If well telescopes please
sketch and show depths.

GROUND LEVEL

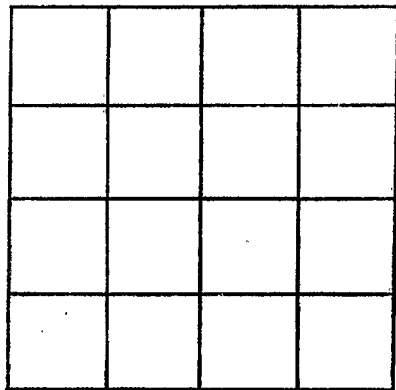

SECTION _____

Please indicate well location X.

ADDITIONAL INFORMATION

If more than one screen,
show locations of each on sketch.