

MISSISSIPPI DEPARTMENT OF NATURAL RESOURCES

Bureau of Land and Water Resources

Southport Mall

P.O. Box 10631

Jackson, Mississippi 39209

WATER WELL DRILLERS LOG
BUD FENTON & SONS

Water Well Service

Pearl River

firm name Box 402
Carriere, Mississippi 39426

county well located

PEARL RIVER
Φ
2023

12/4 1985
date well completed

LANDOWNER: Bob

Phone 601 798-5324

Delgado
R.T. Carriero
(mailing address)

description of formations encountered	from	to
<u>Blue shale</u>	<u>0</u>	<u>210</u>
<u>Blue sand</u>	<u>210</u>	<u>295</u>
<u>Blue shale</u>	<u>295</u>	<u>490</u>
<u>Blue sand</u>	<u>490</u>	<u>550</u>

WELL LOCATION:

sec. 39 T 4 N R 18 E
S W
6 miles NW of Carriero
(distance) (direction) (nearest town)

WELL PURPOSE: home
(home, irrigation, municipal, industrial)


WELL COMPLETION DATA:

- (1) diameter (inches) 4"
- (2) total depth (feet) 550
- (3) static water level (feet) 90 below top of ground.
- (4) casing PCC, 550,
(material) (depth)
4x2 if telescope see back.
(size)
- (5) screen 2x15, 535
(length) (depth to top)
12, PCC
(size) (material)
- (6) pump 1 900
(HP) (yield gpm)
Elect
(type power)
- (7) electric log no
(yes or no)

(organization running log)

(8) how well bottom plugged good
work

DRILLERS REMARKS:

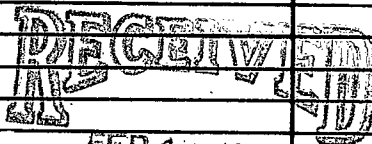

Department of Natural Resources
Bureau of Land & Water Resources

