

MISSISSIPPI DEPARTMENT OF NATURAL RESOURCES

Bureau of Land and Water Resources

Southport Mall

P.O. Box 10631

Jackson, Mississippi 39209

WATER WELL DRILLERS LOG

PEARL RIVER
2095

12/2 19 85
date well completed

BUD PENTON & SONS
firm name
Pearl River
county well located

LANDOWNER: Scott Burge
R-1 Box 294 B
poplarwill miss.
(mailing address)

Rt. 4, Box 402 Pearl River, Mississippi 39426 Phone 601-798-5324 encountered	from to
<u>Red shale</u>	0 60
<u>Red sand</u>	60 80
<u>Blue shale</u>	80 175
<u>Blue sand</u>	175 265
<u>Blue shale</u>	265 490
<u>Drif sand</u>	490 530


WELL LOCATION:
sec. 12 T 4 N R 18 E
S W
12 miles NW of Carriero
(distance) (direction) (nearest town)

WELL PURPOSE: home
(home, irrigation, municipal, industrial)

- WELL COMPLETION DATA:
- diameter (inches) 4"
 - total depth (feet) 530 @ 530
 - static water level (feet) 70 below above top of ground.
 - casing PVC 530
(material) (depth)
4x2 if telescope see back.
(size)
 - screen 10' 5-20
(length) (depth to top)
12 PVC
(size) (material)
 - pump 1 950
(HP) (yield gpm)
Elect
(type power)
 - electric log no
(yes or no)

(organization running log)
 - how well bottom plugged plugged
fresh

DRILLERS REMARKS:

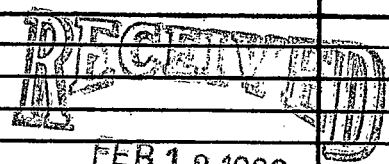


FEB 12 1986

Department of Natural Resources
Bureau of Land and Water Resources

If well telescopes please sketch and show depths.

GROUND LEVEL

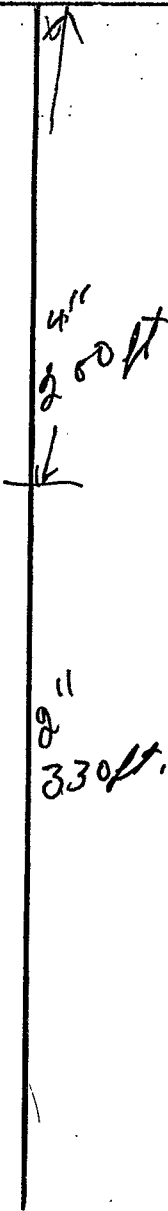

	X		

SECTION _____

Please indicate well location X.

ADDITIONAL INFORMATION

If more than one screen, show locations of each on sketch.