

MISSISSIPPI DEPARTMENT OF NATURAL RESOURCES

Bureau of Land and Water Resources

Southport Mall

P.O. Box 10631

Jackson, Mississippi 39209

WATER WELL DRILLERS LOG

BUD PENTON & SONS

Water Well Service *Earl King*  
 firm name Rt. 4, Box 402 county well located

*Pearl River*  
*Ph 2007*

*1/23* 19 *86*  
 date well completed

LANDOWNER: *John Barnes*

Carriere, Mississippi 39426

*RT-1 Carriere*

description of formations encountered	from	to
<i>Red shale</i>	<i>0</i>	<i>60</i>
<i>Blue shale</i>	<i>60</i>	<i>200</i>
<i>gray sand</i>	<i>200</i>	<i>260</i>
<i>Blue shale</i>	<i>260</i>	<i>490</i>
<i>gray sand</i>	<i>490</i>	<i>670</i>
<i>Blue shale</i>	<i>530</i>	<i>630</i>
<i>gray sand</i>	<i>620</i>	<i>674</i>

(mailing address)

WELL LOCATION:

sec *39* T *4* N R *18* E  
 S W  
*8* miles *W* of *Carriere*  
 (distance) (direction) (nearest town)

WELL PURPOSE: *home*  
 (home, irrigation, municipal, industrial)

WELL COMPLETION DATA:

- (1) diameter (inches) *4*
- (2) total depth (feet) *674*
- (3) static water level (feet) *120* below above top of ground.
- (4) casing *PVC* *674*  
 (material) (depth)
- 4x2* if telescope see back.  
 (size)
- (5) screen *15* *669*  
 (length) (depth to top)
- 12* *PVC*  
 (size) (material)
- (6) pump *2* *1360*  
 (HP) (yield gpm)
- Elect*  
 (type power)
- (7) electric log *no*  
 (yes or no)

(organization running log)

(8) how well bottom plugged *sand*  
*shale*

DRILLERS REMARKS:



RECEIVED

FEB 12 1986

Department of Natural Resources  
 Bureau of Land & Water Resources

If well telescopes please sketch and show depths.

GROUND LEVEL

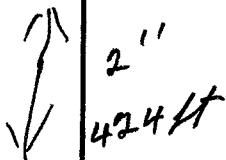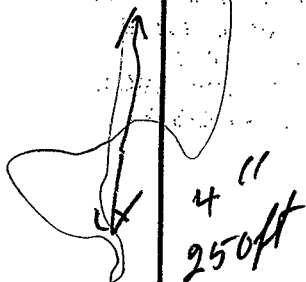


SECTION \_\_\_\_\_

Please indicate well location X.

ADDITIONAL INFORMATION

If more than one screen, show locations of each on sketch.