

MISSISSIPPI DEPARTMENT OF NATURAL RESOURCES

Bureau of Land and Water Resources

P.O. Box 10631

Jackson, Mississippi 39209

WATER WELL DRILLERS LOG

COUNTY WELL LOCATED PEARL RIVER	
WELL NUMBER Φ	CODED
209A	
DATE WELL COMPLETED 10-17-86	

PERMIT NUMBER
NAME OF DRILLING FIRM WALKER WELL DRILLING

NAME & MAILING ADDRESS OF LANDOWNER SHANNON CREEK		
SLIDELL LA.		
504. 646-0475		
WELL LOCATION: SEC	TOWNSHIP	RANGE
39	43	18
	N S	E W
DISTANCE	DIRECTION	NEAREST TOWN
20 Miles	NW	of PICAYUN
OTHER LANDMARK HENLEY FIELD		
WELL PURPOSE: Home, Irrigation, Municipal, Industrial, Fish Pond, etc. HOME		

PUMP DATA		
PUMP TYPE (Circle One): Submersible, Turbine, Jet, <input checked="" type="radio"/> Flowing Well, Other (Describe) MSE		
POWER TYPE (Circle One): <input checked="" type="radio"/> Electric, Tractor, Diesel, Gasoline, Butane, Other (Describe)		
Pump Capacity (GPM) 8	No. of Stages 2	Setting Depth 60 FT.
PUMP TEST		
Well yielded 5 GPM with a drawdown of 2 ft. after 4 hours of pumping		

WELL DATA		
Well Depth 63'	Casing Diameter (In.) 2"	Casing Length (Ft.) 53'
Type of Casing PVC	Hole Depth 65	Depth to Static Water Level
TYPE OF COMPLETION: (Circle One or More): Gravel Packed, Underreamed, Telescoped, <input checked="" type="radio"/> Natural Development, <input type="radio"/> Open Hole, <input type="radio"/> Other (Describe) AIR		
Top of Lap Pipe or Reduction in Casing FEET		
IF TELESCOPED OR MORE THAN ONE SCREEN: USE BACK PAGE		

LOG DATA	
TYPE OF LOG RUN (Circle One): No Log Run, Electric, Gamma Ray, Density, Sonic, Neutron, Other (Describe)	
Name of Organization Running Log	

SCREEN DATA		
Diameter - Inches 2"	Length - Feet 10'	Slot Size - Inches 10
Screen Type PVC Slotted	Depth to Bottom - Feet 63 ft.	

GEOLOGIC DATA (Office Use Only)			
Surface Elev.	Geologic Unit	Unit Thickness	Depth to Top
Subs. SWL	Date	Analysis	Aquifer Test

Driller's Remarks


RECEIVED

DESCRIPTION OF FORMATIONS ENCOUNTERED	FROM	TO	FORMATIONS (continued)	FROM	TO
RED CLAY	0	20	<div style="font-size: 2em; font-weight: bold; opacity: 0.5;">NOV 20 1986</div> <p style="text-align: right; font-weight: bold;">Department of Natural Resources Bureau of Land & Water Resources</p>		
RED SAND	20	36			
WHITE SAND	36	63			
ROCKS					

IF MORE SPACE IS NEEDED, USE BACK

If well telescopes please sketch and show depths.

GROUND LEVEL

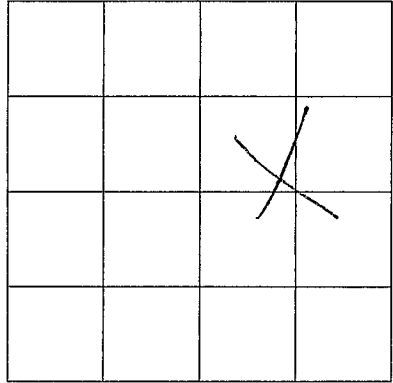

SECTION _____

Please indicate well location X.

ADDITIONAL INFORMATION

If more than one screen,
show location of each on sketch.