

MISSISSIPPI DEPARTMENT OF NATURAL RESOURCES
Bureau of Land and Water Resources
 Southport Mall
 P.O. Box 10631
 Jackson, Mississippi 39209
WATER WELL DRILLERS LOG

<u>Pearl River</u>
Φ
2100

March 21 19 86 Walkers Welding Pearl River
 date well completed firm name county well located

LANDOWNER: Warren Knight
 Rt. 1 Carriere
 (mailing address)

description of formations encountered	from	to
Red Clay	0	16
Sand	16	72

WELL LOCATION:
 sec. 23 T 4 N R 18 E
 14 miles NW of Picayune
 (distance) (direction) (nearest town)

WELL PURPOSE: Home
 (home, irrigation, municipal, industrial)

- WELL COMPLETION DATA:**
- (1) diameter (inches) 4
 - (2) total depth (feet) 72'
 - (3) static water level (feet) 30' below above top of ground.
 - (4) casing PVC 62'
 (material) (depth)
 (size) if telescope see back.
 - (5) screen 10' 62'
 (length) (depth to top)
#10 PVC
 (size) (material)
 - (6) pump 1/2 8
 (HP) (yield gpm)
Electric
 (type power)
 - (7) electric log (yes or no) _____
 (organization running log) _____
 - (8) how well bottom plugged sand shark


RECEIVED
APR 28 1986

DRILLERS REMARKS:

Department of Natural Resources
 Bureau of Land & Water Resources

If well telescopes please sketch and show depths.

GROUND LEVEL

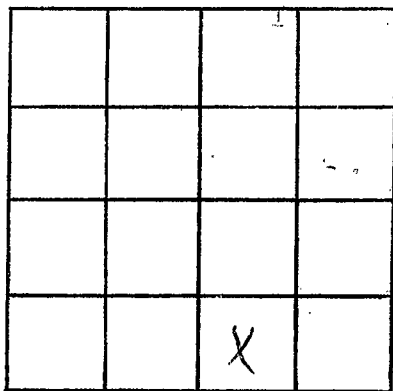

SECTION _____

Please indicate well location X.

ADDITIONAL INFORMATION

If more than one screen,
show locations of each on sketch.