

Pearl River  
 Ⓞ  
2101


MISSISSIPPI DEPARTMENT OF NATURAL RESOURCES  
 Bureau of Land and Water Resources  
 Southport Mall  
 P.O. Box 10631  
 Jackson, Mississippi 39209  
**WATER WELL DRILLERS LOG**

May 23 19 86 Walkers Welding Pearl River  
 date well completed firm name county well located

LANDOWNER: <u>B. Danton</u> <u>5513 Chatham Drive</u>	description of formations encountered	from	to
<u>7022 N.O. 501-282-7973</u> (mailing address)	Clay	0	T0
<b>WELL LOCATION:</b> sec. <u>T3T</u> <u>11</u> <u>S</u> R. <u>T8</u> <u>W</u> <u>1/6</u> miles <u>N.W.</u> of <u>Picayune</u> (distance) (direction) (nearest town)	Clay Sand	T0	T8
<b>WELL PURPOSE:</b> <u>Home</u> (home, irrigation, municipal, industrial)	Clay	T8	54
<b>WELL COMPLETION DATA:</b>	Black @ Gray Clay	54	T20
(1) diameter (inches) <u>1 1/2"</u>	Sand	T20	T40
(2) total depth (feet) <u>155</u>			
(3) static water level (feet) <u>50'</u> below top of ground.			
(4) casing <u>PVC</u> <u>1 1/2"</u> (material) (depth)			
<u>    </u> if telescope see back. (size)			
(5) screen <u>#10</u> <u>1 1/2"</u> (length) (depth to top)			
<u>1 1/2"</u> <u>PVC</u> (size) (material)			
(6) pump <u>1</u> <u>8 gpm</u> (HP) (yield gpm)			
(7) electric log <u>    </u> (yes or no)			
<u>    </u> (organization running log)			
(8) how well bottom plugged <u>Sand</u> <u>Shark</u>			
<b>DRILLERS REMARKS:</b>			

If well telescopes please sketch and show depths.

GROUND LEVEL

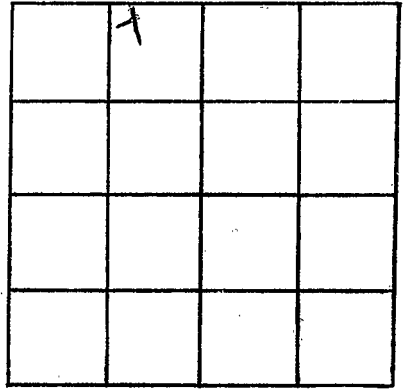

SECTION \_\_\_\_\_

Please indicate well location X.

ADDITIONAL INFORMATION

If more than one screen,  
show locations of each on sketch.