

MISSISSIPPI DEPARTMENT OF NATURAL RESOURCES

Bureau of Land and Water Resources

Southport Mall

P.O. Box 10631


Jackson, Mississippi 39209

WATER WELL DRILLERS LOG

PEARL RIVER
 Ⓟ
 2103


Aug 13 19 86 Walkers Welding Pearl River
 date well completed firm name county well located

LANDOWNER: <u>John Rosen</u> <u>Rt 1 Box 227</u>	description of formations encountered	from	to
<u>CARRERE</u> (mailing address)			
WELL LOCATION: sec <u>39</u> T <u>4</u> N R <u>18</u> E <u>20</u> miles <u>NW</u> of <u>Picayune</u> (distance) (direction) (nearest town)	red clay	0	16
WELL PURPOSE: <u>Home</u> (home, irrigation, municipal, industrial)	red sand	16	60
WELL COMPLETION DATA:	blue clay	60	101
(1) diameter (inches) <u>8 1/2</u>	sand	101	188 1/2
(2) total depth (feet) <u>188 1/2</u>			
(3) static water level (feet) <u>90'</u> below above top of ground.			
(4) casing <u>PVC</u> <u>172'</u> (material) (depth)			
<u> </u> if telescope see back. (size)			
(5) screen <u>15'</u> <u>172'</u> (length) (depth to top)			
<u> </u> <u>PVC</u> (size) (material)			
(6) pump <u>1</u> <u>20</u> (HP) (yield gpm)			
<u>ELC</u> (type power)			
(7) electric log <u> </u> (yes or no)			
<u> </u> (organization running log)			
(8) how well bottom plugged <u>sand shank</u>			
DRILLERS REMARKS:			

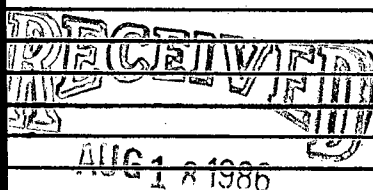

If well telescopes please
sketch and show depths.

GROUND LEVEL

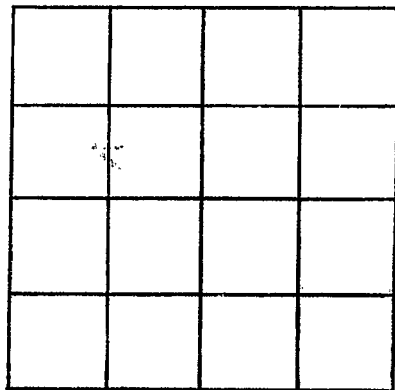

SECTION _____

Please indicate well location X.

ADDITIONAL INFORMATION

If more than one screen,
show locations of each on sketch.