

# MISSISSIPPI DEPARTMENT OF NATURAL RESOURCES

Bureau of Land and Water Resources

P.O. Box 10631

Jackson, Mississippi 39209

## WATER WELL DRILLERS LOG

COUNTY WELL LOCATED <b>PEARL RIVER</b>	
WELL NUMBER <b>Φ</b>	CODED
<b>2105</b>	
DATE WELL COMPLETED <b>1-8-89</b>	

PERMIT NUMBER <b>0428</b>
NAME OF DRILLING FIRM <b>WALKER'S WELL DRILLING</b>

NAME & MAILING ADDRESS OF LANDOWNER  
**MR. RAY MARTIN  
RT1 CARRIERE  
MISS**

WELL LOCATION: SEC TOWNSHIP RANGE  
**24 45 N 18 E**

DISTANCE DIRECTION NEAREST TOWN  
**17 Miles SW of Prentiss**

OTHER LANDMARK

WELL PURPOSE: Home, Irrigation, Municipal, Industrial, Fish Pond, etc.  
**HOME**

**PUMP DATA**

PUMP TYPE (Circle One):  
Submersible, Turbine, **Jet** Flowing Well,  
Other (Describe)

POWER TYPE (Circle One):  
**Electric**, Tractor, Diesel, Gasoline, Butane,  
Other (Describe)

Pump Capacity (GPM) <b>10</b>	No. of Stages <b>2</b>	Setting Depth <b>95</b> FT.
----------------------------------	---------------------------	--------------------------------

**PUMP TEST**

Well yielded \_\_\_\_\_ GPM with  
a drawdown of \_\_\_\_\_ ft.  
after \_\_\_\_\_ hours of pumping

**WELL DATA**

Well Depth <b>90</b>	Casing Diameter (In.) <b>2"</b>	Casing Length (Ft.) <b>80'</b>
Type of Casing <b>PVC</b>	Hole Depth <b>92</b>	Depth to Static Water Level <b>56'</b>

TYPE OF COMPLETION: (Circle One or More):  
Gravel Packed, Underreamed, Telescoped,  
**Natural Development**, Open Hole, Other

Top of Lap Pipe or Reduction in Casing  
FEET IF TELESKOPED OR MORE THAN ONE SCREEN: USE BACK PAGE

**LOG DATA**

TYPE OF LOG RUN (Circle One): No Log Run, Electric, Gamma Ray, Density, Sonic, Neutron, Other (Describe)

Name of Organization Running Log

**SCREEN DATA**

Diameter - Inches <b>2"</b>	Length - Feet <b>10'</b>	Slot Size - Inches <b>#10</b>
Screen Type <b>SLOT</b>	Depth to Bottom - Feet <b>90</b>	

**GEOLOGIC DATA (Office Use Only)**

Surface Elev.	Geologic Unit	Unit Thickness	Depth to Top
Subs. SWL	Date	Analysis	Aquifer Test


Driller's Remarks

DESCRIPTION OF FORMATIONS ENCOUNTERED	FROM	TO
<b>Red clay</b>	<b>0</b>	<b>25</b>
<b>SAND</b>	<b>25</b>	<b>90</b>

FORMATIONS (Continued) FROM TO			
<b>RECEIVED</b>			
		<b>FEB 04 1989</b>	
		<b>Department of Natural Resources Bureau of Land &amp; Water Resources</b>	
IF MORE SPACE IS NEEDED, USE BACK			

If well telescopes please sketch and show depths.

GROUND LEVEL

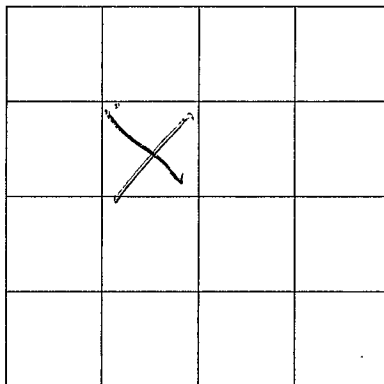

SECTION \_\_\_\_\_

Please indicate well location X.

ADDITIONAL INFORMATION

If more than one screen, show location of each on sketch.