

MISSISSIPPI DEPARTMENT OF NATURAL RESOURCES

Bureau of Land and Water Resources

Southport Mall

P.O. Box 10631

Jackson, Mississippi 39209

WATER WELL DRILLERS LOG

BUD PENTON & SONS

Water Well Service

firm name Rt. 4, Box 402 county well located

PEARCE RIVER  
D2109

6/1 1987  
date well completed

LANDOWNER: Mrs. Sudeen

Rt. 1 Box  
Carriere Miss 39426  
(mailing address)

Carriere, Mississippi 39426

description of formations encountered  
Phone No. 798-5324

from to

Red shale  
Red sand

6 38  
38 73

WELL LOCATION:

sec. 25 T. 4 N R. 18 E  
S W  
4 miles West Carriere  
(distance) (direction) (nearest town)

WELL PURPOSE: Home  
(home, irrigation, municipal, industrial)

WELL COMPLETION DATA:

- (1) diameter (inches) 4
- (2) total depth (feet) 73
- (3) static water level (feet) 40 below top of ground.
- (4) casing PVC 73 (material) (depth)  
20 (size) if telescope see back.
- (5) screen 4x10 63 (length) (depth to top)  
1 1/2 PVC (size) (material)
- (6) pump 1 22 (HP) (yield gpm)  
Elect (type power)
- (7) electric log 30 (yes or no)

(organization running log)

(8) how well bottom plugged sand  
Shark

DRILLERS REMARKS:


RECEIVED

AUG 13 1987

Department of Natural Resources  
Bureau of Land & Water Resources

If well telescopes please sketch and show depths.

GROUND LEVEL

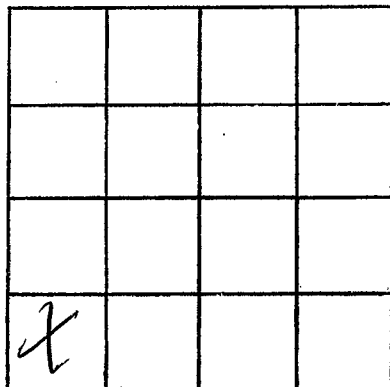

SECTION \_\_\_\_\_

Please indicate well location X.

ADDITIONAL INFORMATION

If more than one screen,  
show locations of each on sketch.