

# MISSISSIPPI DEPARTMENT OF NATURAL RESOURCES

Bureau of Land and Water Resources

COUNTY WELL LOCATED  
**PEARL RIVER**

WELL NUMBER **Q2111** CODED

**4-2-87**  
 DATE WELL COMPLETED

PERMIT NUMBER **0-428**

NAME OF DRILLING FIRM  
**WALKER'S WELL DRILLING**  
**+ REPAIR SHOP**

P.O. Box 10631  
 Jackson, Mississippi 39209  
**WATER WELL DRILLERS LOG**

NAME & MAILING ADDRESS OF LANDOWNER  
**JAMES FORTENBERG**  
**HENLEEFIELD**

WELL LOCATION: SEC **38** TOWNSHIP **4** RANGE **N 18 E**

DISTANCE **18** Miles DIRECTION **NW** of NEAREST TOWN **PICAYUNE**

OTHER LANDMARK  
**HOME**

WELL PURPOSE:  Home Irrigation, Municipal, Industrial, Fish Pond, etc.

**PUMP DATA**

PUMP TYPE (Circle One):  
 Submersible, Turbine,  **Jet** Flowing Well,  
 Other (Describe) \_\_\_\_\_

POWER TYPE (Circle One):  
 Electric, Tractor, Diesel, Gasoline, Butane,  
 Other (Describe) \_\_\_\_\_

Pump Capacity (GPM) <b>8</b>	No. of Stages <b>2</b>	Setting Depth <b>40'</b> FT.
---------------------------------	---------------------------	---------------------------------

PUMP TEST  
 Well yielded \_\_\_\_\_ GPM with  
 a drawdown of \_\_\_\_\_ ft.  
 after \_\_\_\_\_ hours of pumping

**WELL DATA**

Well Depth <b>54</b>	Casing Diameter (In.) <b>2"</b>	Casing Length (Ft.) <b>44'</b>
Type of Casing <b>POC</b>	Hole Depth <b>55'</b>	Depth to Static Water Level <b>30'</b>

TYPE OF COMPLETION: (Circle One or More):  
 Gravel Packed,  Underreamed,  Telescoped,  
 Natural Development,  Open Hole,  Other  
 (Describe) **AIR**

Top of Lap Pipe or Reduction in Casing  
 FEET IF TELESKOPED OR MORE THAN ONE SCREEN: USE BACK PAGE

**LOG DATA**

TYPE OF LOG RUN (Circle One):  
 No Log Run, Electric, Gamma Ray, Density, Sonic, Neutron,  
 Other (Describe) \_\_\_\_\_

Name of Organization Running Log

**SCREEN DATA**

Diameter - Inches <b>2"</b>	Length - Feet <b>105'</b>	Slot Size - Inches <b>8</b>
Screen Type <b>J. WRAP</b>	Depth to Bottom - Feet <b>54</b>	

**GEOLOGIC DATA (Office Use Only)**

Surface Elev.	Geologic Unit	Unit Thickness	Depth to Top
Subs. SWL	Date	Analysis	Aquifer Test

Driller's Remarks

RECEIVED


DESCRIPTION OF FORMATIONS ENCOUNTERED	FROM	TO	FORMATIONS (Continued)	FROM	TO
CLAY RED	0	20	<div style="font-size: 1.5em; font-weight: bold;">MAY 14 1987</div>		
SAND RED	20	35			
WHITE SAND	35	54'			

**Department of Natural Resources**  
**Bureau of Land & Water Resources**

IF MORE SPACE IS NEEDED, USE BACK

If well telescopes please  
sketch and show depths.

GROUND LEVEL

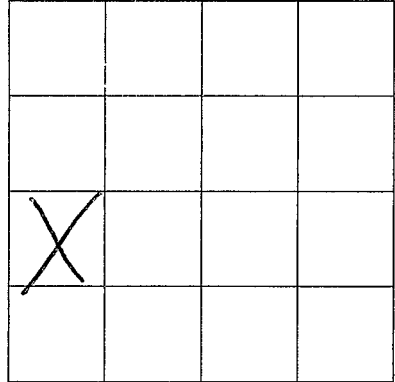

SECTION \_\_\_\_\_

Please indicate well location X.

ADDITIONAL INFORMATION

If more than one screen,  
show location of each on sketch.