

MISSISSIPPI DEPARTMENT OF NATURAL RESOURCES

Bureau of Land and Water Resources

P.O. Box 10631

Jackson, Mississippi 39209

WATER WELL DRILLERS LOG

COUNTY WELL LOCATED	
<i>Pearl River</i>	
WELL NUMBER	CODED
<i>0</i>	
<i>2113</i>	
DATE WELL COMPLETED	
<i>4-9-87</i>	

PERMIT NUMBER
<i>0.428</i>
NAME OF DRILLING FIRM
<i>WALKERS WELL DRILLING</i>

NAME & MAILING ADDRESS OF LANDOWNER			
<i>NEAL NEWLY</i>			
<i>GEOGREWISERD</i>			
WELL LOCATION: SEC TOWNSHIP RANGE			
<i>38</i>	<i>4</i>	<i>N</i>	<i>18</i>
DISTANCE DIRECTION NEAREST TOWN			
<i>16</i>	<i>Miles</i>	<i>NW</i>	<i>of PICAUNE</i>
OTHER LANDMARK			
WELL PURPOSE: Home, Irrigation, Municipal, Industrial, Fish Pond, etc.			
<i>HOME</i>			

PUMP DATA		
PUMP TYPE (Circle One):		
Submersible, Turbine, Other (Describe)	<i>Jet</i>	Flowing Well,
POWER TYPE (Circle One):		
Electric, Tractor, Diesel, Gasoline, Butane, Other (Describe)		
Pump Capacity (GPM)	No. of Stages	Setting Depth
<i>12</i>	<i>2</i>	<i>40' FT.</i>
PUMP TEST		
Well yielded _____ GPM with a drawdown of _____ ft. after _____ hours of pumping		

WELL DATA		
Well Depth	Casing Diameter (In.)	Casing Length (Ft.)
<i>85'</i>	<i>2"</i>	<i>80'</i>
Type of Casing	Hole Depth	Depth to Static Water Level
<i>PVC</i>	<i>86'</i>	<i>25'</i>
TYPE OF COMPLETION: (Circle One or More):		
Gravel Packed, Underreamed, Telescoped, Natural Development, Open Hole, Other		
(Describe) <i>AIR</i>		
Top of Lap Pipe or Reduction in Casing		
FEET	IF TELESCOPED OR MORE THAN ONE SCREEN: USE BACK PAGE	

LOG DATA	
TYPE OF LOG RUN (Circle One):	
No Log Run, Electric, Gamma Ray, Density, Sonic, Neutron, Other (Describe)	
Name of Organization Running Log	

SCREEN DATA		
Diameter - Inches	Length - Feet	Slot Size - Inches
<i>2"</i>	<i>5'</i>	<i>#8</i>
Screen Type	Depth to Bottom - Feet	
<i>JWRAP</i>	<i>85'</i>	

GEOLOGIC DATA (Office Use Only)			
Surface Elev.	Geologic Unit	Unit Thickness	Depth to Top
Subs. SWL	Date	Analysis	Aquifer Test

Driller's Remarks
RECEIVED

MAY 14 1987


DESCRIPTION OF FORMATIONS ENCOUNTERED	FROM	TO	FORMATIONS (Continued)	FROM	TO
<i>REPCLAY</i>	<i>0</i>	<i>10</i>			
<i>SAND</i>	<i>10</i>	<i>20</i>			
<i>GRAVEL</i>	<i>20</i>	<i>85</i>			

Department of Natural Resources
Bureau of Land & Water Resources

IF MORE SPACE IS NEEDED, USE BACK

If well telescopes please
sketch and show depths.

GROUND LEVEL

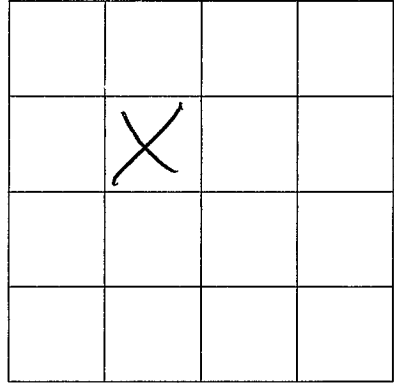

SECTION _____

Please indicate well location X.

ADDITIONAL INFORMATION

If more than one screen,
show location of each on sketch.