

MISSISSIPPI DEPARTMENT OF NATURAL RESOURCES

Bureau of Land and Water Resources

P.O. Box 10631

Jackson, Mississippi 39209

WATER WELL DRILLERS LOG

COUNTY WELL LOCATED
PEARL RIVER

WELL NUMBER Φ	CODED
2115	
DATE WELL COMPLETED 6-10-87	

PERMIT NUMBER
NAME OF DRILLING FIRM WALKERS well
DRILLING

NAME & MAILING ADDRESS OF LANDOWNER

TOM KENNEDY
HENLEFIELD MISS.

WELL LOCATION: SEC 39 TOWNSHIP 4 N RANGE 18 E (W)

DISTANCE 12 Miles DIRECTION SW of NEAREST TOWN PEARL RIVER

OTHER LANDMARK HENLEFIELD

WELL PURPOSE Home Irrigation, Municipal, Industrial, Fish Pond, etc.

PUMP DATA

PUMP TYPE (Circle One): Submersible, Turbine, Jet, Flowing Well, Other (Describe) 35GPM

POWER TYPE (Circle One): Electric, Tractor, Diesel, Gasoline, Butane, Other (Describe)

Pump Capacity (GPM)	No. of Stages	Setting Depth
35	9	140 FT.

PUMP TEST

Well yielded 40 GPM with a drawdown of _____ ft. after _____ hours of pumping

WELL DATA

Well Depth	Casing Diameter (in.)	Casing Length (Ft.)
300	4"	300
Type of Casing	Hole Depth	Depth to Static Water Level
PVC	307	100'

TYPE OF COMPLETION: (Circle One or More): Gravel Packed, Underreamed, Telescoped, Natural Development, Open Hole, Other (Describe) AIR

Top of Lap Pipe or Reduction in Casing

FEET IF TELESCOPED OR MORE THAN ONE SCREEN: USE BACK PAGE

LOG DATA

TYPE OF LOG RUN (Circle One): No Log Run, Electric, Gamma Ray, Density, Sonic, Neutron, Other (Describe)

Name of Organization Running Log

SCREEN DATA

Diameter - Inches	Length - Feet	Slot Size - Inches
4"	20'	1/10
Screen Type	Depth to Bottom - Feet	
SLOTS	300	

GEOLOGIC DATA (Office Use Only)

Surface Elev.	Geologic Unit	Unit Thickness	Depth to Top
Subs. SWL	Date	Analysis	Aquifer Test

Driller's Remarks

DESCRIPTION OF FORMATIONS ENCOUNTERED	FROM	TO
SAND	0	30
WHITE CLAY	30	60
RED CLAY	60	100
HARD CLAY	100	160
BLUE CLAY	160	250
SAND	250	300

RECEIVED


AUG 03 1987

Department of Natural Resources
Bureau of Land & Water Resources

IF MORE SPACE IS NEEDED, USE BACK

If well telescopes please
sketch and show depths.

GROUND LEVEL

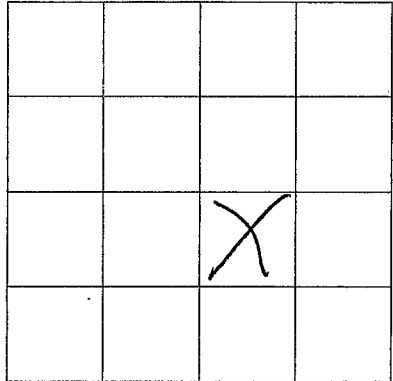

SECTION _____

Please indicate well location X.

ADDITIONAL INFORMATION

A series of horizontal lines for writing additional information.

If more than one screen,
show location of each on sketch.