

MISSISSIPPI DEPARTMENT OF NATURAL RESOURCES

Bureau of Land and Water Resources

P.O. Box 10631

Jackson, Mississippi 39209

WATER WELL DRILLERS LOG

COUNTY WELL LOCATED PEARL RIVER	
WELL NUMBER Φ	CODED
219	
DATE WELL COMPLETED 3-26-88	

PERMIT NUMBER 0428
NAME OF DRILLING FIRM WALKER'S WELL SERVICE

NAME & MAILING ADDRESS OF LANDOWNER BUTCH JACKSON Rt. 1 Carriere MS.			
WELL LOCATION: SEC	TOWNSHIP	RANGE	
11	4	N	18
DISTANCE		DIRECTION	NEAREST TOWN
17 Miles		N	PICAYUNE
OTHER LANDMARK HENLOE FIELD			
WELL PURPOSE: <input checked="" type="radio"/> Home, <input type="radio"/> Irrigation, <input type="radio"/> Municipal, <input type="radio"/> Industrial, <input type="radio"/> Fish Pond, etc.			

PUMP DATA		
PUMP TYPE (Circle One): <input checked="" type="radio"/> Submersible, <input type="radio"/> Turbine, <input type="radio"/> Jet, <input type="radio"/> Flowing Well, Other (Describe) _____		
POWER TYPE (Circle One): <input checked="" type="radio"/> Electric, <input type="radio"/> Tractor, <input type="radio"/> Diesel, <input type="radio"/> Gasoline, <input type="radio"/> Butane, Other (Describe) _____		
Pump Capacity (GPM)	No. of Stages	Setting Depth
	8	130 FT.
PUMP TEST		
Well yielded 8 GPM with a drawdown of _____ ft. after _____ hours of pumping		

WELL DATA		
Well Depth 252	Casing Diameter (In.) 4"	Casing Length (Ft.) 242
Type of Casing PVC	Hole Depth 254	Depth to Static Water Level 100'
TYPE OF COMPLETION: (Circle One or More): <input checked="" type="radio"/> Gravel Packed, <input type="radio"/> Underreamed, <input type="radio"/> Telescoped, <input checked="" type="radio"/> Natural Development, <input type="radio"/> Open Hole, <input type="radio"/> Other (Describe) AER		
Top of Lap Pipe or Reduction in Casing FEET <input type="checkbox"/> IF TELESCOPED OR MORE THAN ONE SCREEN: USE BACK PAGE		

LOG DATA	
TYPE OF LOG RUN (Circle One): <input type="radio"/> No Log Run, <input type="radio"/> Electric, <input type="radio"/> Gamma Ray, <input type="radio"/> Density, <input type="radio"/> Sonic, <input type="radio"/> Neutron, Other (Describe) _____	
Name of Organization Running Log	

SCREEN DATA		
Diameter - Inches 2"	Length - Feet 10'	Slot Size - Inches #10
Screen Type WRAP	Depth to Bottom - Feet 252	

GEOLOGIC DATA (Office Use Only)			
Surface Elev.	Geologic Unit	Unit Thickness	Depth to Top
Subs. SWL	Date	Analysis	Aquifer Test


Driller's Remarks	

DESCRIPTION OF FORMATIONS ENCOUNTERED	FROM	TO	FORMATIONS (Continued)	FROM	TO
CLAY WHITE SAND	0	25	<div style="font-size: 2em; font-weight: bold; opacity: 0.5;">RECEIVED</div> <div style="font-size: 1.5em; font-weight: bold; margin-top: 10px;">APR 15 1988</div> <div style="font-weight: bold; margin-top: 10px;">Department of Natural Resources Bureau of Land & Water Resources</div>		
RED CLAY	25	65			
BLUE CLAY	65	100			
WHITE CLAY	100	150			
SAND	150	210			
SAND	210	252			


IF MORE SPACE IS NEEDED, USE BACK

If well telescopes please sketch and show depths.

GROUND LEVEL

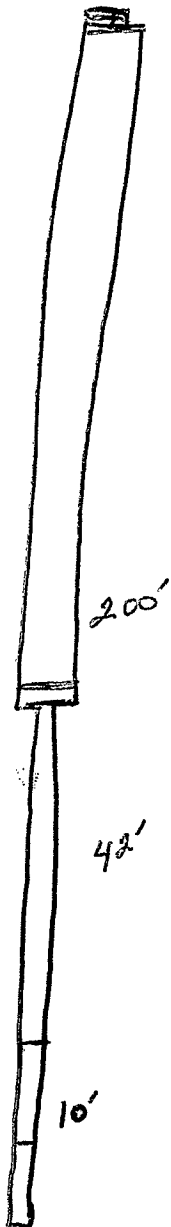

If more than one screen, show location of each on sketch.

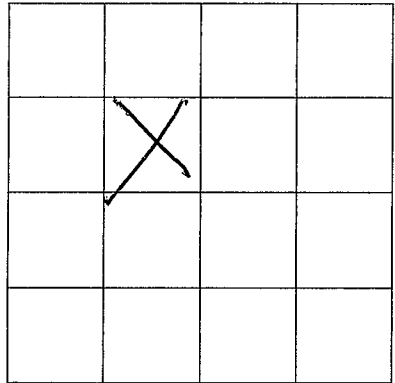

SECTION _____

Please indicate well location X.

ADDITIONAL INFORMATION

Blank lines for additional information.