

MISSISSIPPI DEPARTMENT OF NATURAL RESOURCES

Bureau of Land and Water Resources

P.O. Box 10631

Jackson, Mississippi 39209

WATER WELL DRILLERS LOG

COUNTY WELL LOCATED PEARL RIVER	
WELL NUMBER Φ	CODED
2120	
DATE WELL COMPLETED 4-9-88	

PERMIT NUMBER 0428
NAME OF DRILLING FIRM WALKER'S
WELL SERVICE

NAME & MAILING ADDRESS OF LANDOWNER SHANNON CREEK			
Rt. 1 Corriere, MS			
WELL LOCATION:	SEC	TOWNSHIP	RANGE
	14	4	N 18 E
DISTANCE	DIRECTION	NEAREST TOWN	
17 Miles	N	of Pennington	
OTHER LANDMARK			
WELL PURPOSE: Home, Irrigation, Municipal, Industrial, Fish Pond, etc.			

PUMP DATA		
PUMP TYPE (Circle One): <input checked="" type="radio"/> Submersible, Turbine, Jet, Flowing Well, Other (Describe) _____		
POWER TYPE (Circle One): <input checked="" type="radio"/> Electric, Tractor, Diesel, Gasoline, Butane, Other (Describe) _____		
Pump Capacity (GPM)	No. of Stages	Setting Depth
	8	100 FT.
PUMP TEST		
Well yielded 8 GPM with a drawdown of _____ ft. after _____ hours of pumping		

WELL DATA		
Well Depth 125	Casing Diameter (In.) 4"	Casing Length (Ft.) 115
Type of Casing PVC	Hole Depth 130	Depth to Static Water Level 50'
TYPE OF COMPLETION: (Circle One or More): <input checked="" type="checkbox"/> Gravel Packed, <input type="checkbox"/> Underreamed, <input type="checkbox"/> Telescoped, <input checked="" type="checkbox"/> Natural Development, <input type="checkbox"/> Open Hole, <input type="checkbox"/> Other (Describe) AIR		
Top of Lap Pipe or Reduction in Casing FEET <input type="checkbox"/> IF TELESCOPED OR MORE THAN ONE SCREEN: USE BACK PAGE		

LOG DATA			
TYPE OF LOG RUN (Circle One): No Log Run, <input checked="" type="radio"/> Electric, Gamma Ray, Density, Sonic, Neutron, Other (Describe) _____			
Name of Organization Running Log			

SCREEN DATA		
Diameter - Inches 2"	Length - Feet 10'	Slot Size - Inches #10
Screen Type S-WRAP	Depth to Bottom - Feet 125'	


GEOLOGIC DATA (Office Use Only)			
Surface Elev.	Geologic Unit	Unit Thickness	Depth to Top
Subs. SWL	Date	Analysis	Aquifer Test
Driller's Remarks			

DESCRIPTION OF FORMATIONS ENCOUNTERED	FROM	TO	FORMATIONS (Continued)	FROM	TO
SANDY CLAY	0	70	<div style="font-size: 2em; font-weight: bold; opacity: 0.5;">RECEIVED</div> <div style="font-size: 1.5em; font-weight: bold; margin-top: 10px;">APR 15 1988</div> <div style="font-weight: bold; margin-top: 10px;">Department of Natural Resources Bureau of Land & Water Resources</div>		
RED CLAY	70	80			
BLUE CLAY	80	90			
SAND	90	125'			

IF MORE SPACE IS NEEDED, USE BACK

If well telescopes please sketch and show depths.

GROUND LEVEL

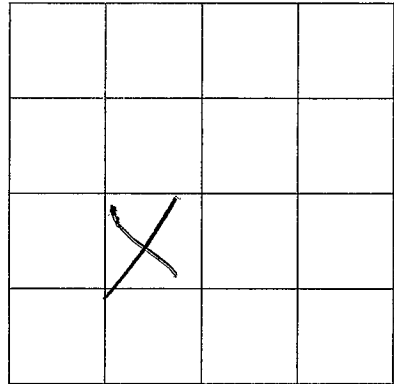

SECTION _____

Please indicate well location X.

ADDITIONAL INFORMATION

Lined area for additional information.

If more than one screen, show location of each on sketch.