

MISSISSIPPI DEPARTMENT OF NATURAL RESOURCES
Bureau of Land and Water Resources

P.O. Box 10631
Jackson, Mississippi 39209
WATER WELL DRILLERS LOG

COUNTY WELL LOCATED
PEARL RIVER

WELL NUMBER **0** CODED

2125

DATE WELL COMPLETED
6-19-88

PERMIT NUMBER
0.428 LN

NAME OF DRILLING FIRM
WARR

NAME & MAILING ADDRESS OF LANDOWNER
R.V. MATHER'S
Henley field
Ant. Communication

WELL LOCATION: SEC **13** TOWNSHIP **13 N** RANGE **18 E** (W)

DISTANCE **15** Miles **NW** of **PICAYUNE**

OTHER LANDMARK

WELL PURPOSE: Home, Irrigation, Municipal, Industrial, Fish Pond, etc.

PUMP DATA

PUMP TYPE (Circle One): ~~Other~~ Turbine, **Jet** Flowing Well, Other (Describe) _____

POWER TYPE (Circle One): **Electric** Tractor, Diesel, Gasoline, Butane, Other (Describe) _____

Pump Capacity (GPM) _____ No. of Stages _____ Setting Depth _____ FT.

PUMP TEST

Well yielded _____ GPM with a drawdown of _____ ft. after _____ hours of pumping

WELL DATA

Well Depth 100'	Casing Diameter (In.) 2"	Casing Length (Ft.) 90'
Type of Casing PVC	Hole Depth 101	Depth to Static Water Level 10'

TYPE OF COMPLETION: (Circle One or More):
~~Gravel Packed, Underreamed, Telescoped, Natural Development, Open Hole, Other~~
AAR

Top of Lap Pipe or Reduction in Casing
FEET _____ IF TELESCOPED OR MORE THAN ONE SCREEN: USE BACK PAGE

LOG DATA

TYPE OF LOG RUN (Circle One): No Log Run, Electric, Gamma Ray, Density, Sonic, Neutron, Other (Describe) _____

Name of Organization Running Log _____

SCREEN DATA

Diameter - Inches 2"	Length - Feet 10'	Slot Size - Inches #12
Screen Type SLOT	Depth to Bottom - Feet 100'	

GEOLOGIC DATA (Office Use Only)

Surface Elev.	Geologic Unit	Unit Thickness	Depth to Top
Subs. SWL	Date	Analysis	Aquifer Test


Driller's Remarks

DESCRIPTION OF FORMATIONS ENCOUNTERED	FROM	TO	FORMATIONS (Continued)	FROM	TO
CLAY	0	70	RECEIVED AUG 22 1988 Department of Natural Resources Bureau of Land & Water Resources		
SANDY CLAY	10	25			
SAND	25	100			

IF MORE SPACE IS NEEDED, USE BACK

If well telescopes please
sketch and show depths.

GROUND LEVEL

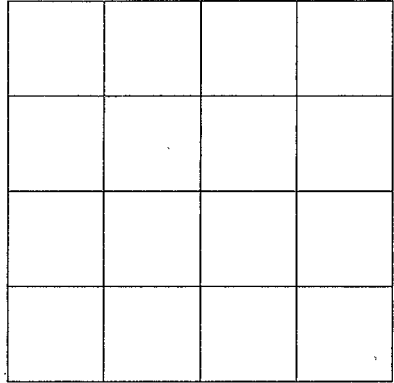

SECTION _____

Please indicate well location X.

ADDITIONAL INFORMATION

If more than one screen,
show location of each on sketch.