

MISSISSIPPI DEPARTMENT OF NATURAL RESOURCES

Bureau of Land and Water Resources

P.O. Box 10631

Jackson, Mississippi 39209

WATER WELL DRILLERS LOG

COUNTY WELL LOCATED P. RIVER	
WELL NUMBER Φ	CODED
2129	
DATE WELL COMPLETED 1-25-89	

PERMIT NUMBER 0-428
NAME OF DRILLING FIRM WALKERSWELL SERVICE

NAME & MAILING ADDRESS OF LANDOWNER GENE CAFONTAYNE RT 1 HENLEFIELD			
WELL LOCATION: SEC	TOWNSHIP	RANGE	
23	4	N 19 E	18
DISTANCE	DIRECTION	NEAREST TOWN	
Miles _____ of _____			
OTHER LANDMARK 1 MILE PASS BALLPARK			
WELL PURPOSE: Home, Irrigation, Municipal, Industrial, Fish Pond, etc.			

PUMP DATA		
PUMP TYPE (Circle One): Submersible, Turbine, Jet <input checked="" type="checkbox"/> Flowing Well, Other (Describe) _____		
POWER TYPE (Circle One): <input checked="" type="checkbox"/> Electric, Tractor, Diesel, Gasoline, Butane, Other (Describe) _____		
Pump Capacity (GPM) 9	No. of Stages 1	Setting Depth 60 FT.
PUMP TEST Well yielded _____ GPM with a drawdown of _____ ft. after _____ hours of pumping		

WELL DATA		
Well Depth 72'	Casing Diameter (In.) 2	Casing Length (Ft.) 62
Type of Casing PVC	Hole Depth 72	Depth to Static Water Level 40
TYPE OF COMPLETION: (Circle One or More): Gravel Packed, Underreamed, Telescoped, <input checked="" type="checkbox"/> Natural Development, Open Hole, Other (Describe) AIR		
Top of Lap Pipe or Reduction in Casing FEET IF TELESCOPED OR MORE THAN ONE SCREEN: USE BACK PAGE		

LOG DATA	
TYPE OF LOG RUN (Circle One): No Log Run, Electric, Gamma Ray, Density, Sonic, Neutron, Other (Describe) _____	
Name of Organization Running Log	

SCREEN DATA		
Diameter - Inches 2	Length - Feet 10	Slot Size - Inches #8
Screen Type SLOT		Depth to Bottom - Feet 72


GEOLOGIC DATA (Office Use Only)			
Surface Elev.	Geologic Unit	Unit Thickness	Depth to Top
Subs. SWL	Date	Analysis	Aquifer Test
Driller's Remarks			

DESCRIPTION OF FORMATIONS ENCOUNTERED	FROM	TO	FORMATIONS ENCOUNTERED	FROM	TO
WHITE CLAY	0	10	RECEIVED FEB 8 1989 Department of Natural Resources Bureau of Land & Water Resources		
SAND	10	25			
PINK CLAY	25	50			
SAND	50	72			

IF MORE SPACE IS NEEDED, USE BACK

If well telescopes please sketch and show depths.

GROUND LEVEL

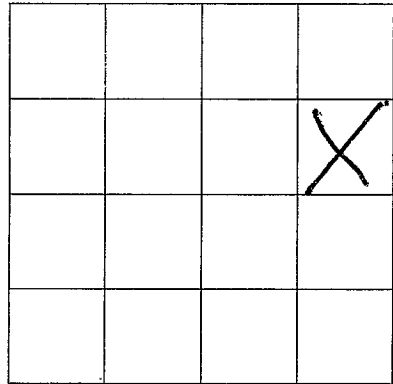

SECTION _____

Please indicate well location X.

ADDITIONAL INFORMATION

If more than one screen,
show location of each on sketch.