

MISSISSIPPI DEPARTMENT OF NATURAL RESOURCES

Bureau of Land and Water Resources

COUNTY WELL LOCATED
PEARL RIVER

WELL NUMBER **0** CODED

2132

DATE WELL COMPLETED
3-16-89

PERMIT NUMBER
0-428

NAME OF DRILLING FIRM
WALKERSWEZC

SERVICE

P.O. Box 10631
Jackson, Mississippi 39209
WATER WELL DRILLERS LOG

NAME & MAILING ADDRESS OF LANDOWNER
VERNON DUKE
Hwy 43 SOUTH

WELL LOCATION: SEC **13** TOWNSHIP **4 N** RANGE **18 E**

DISTANCE **15** Miles DIRECTION **N** of NEAREST TOWN **PICAYUNE**

OTHER LANDMARK

WELL PURPOSE ~~Home~~ Irrigation, Municipal, Industrial, Fish Pond, etc.

PUMP DATA

PUMP TYPE (Circle One):
~~Submersible~~ Turbine, Jet, Flowing Well,
Other (Describe)

POWER TYPE (Circle One):
~~Electric~~ Tractor, Diesel, Gasoline, Butane,
Other (Describe)

Pump Capacity (GPM) 10	No. of Stages 9	Setting Depth 150 FT.
----------------------------------	---------------------------	---------------------------------

PUMP TEST

Well yielded _____ GPM with
a drawdown of _____ ft.
after _____ hours of pumping

WELL DATA

Well Depth 273	Casing Diameter (In.) 4	Casing Length (Ft.) 274
Type of Casing PVC	Hole Depth 288	Depth to Static Water Level 116'

TYPE OF COMPLETION: (Circle One or More):
Gravel Packed, Underreamed, Telescoped,
~~Natural Development~~ Open Hole, Other
(Describe) **AIR**

Top of Lap Pipe or Reduction in Casing
FEET IF TELESCOPED OR MORE THAN ONE SCREEN: USE BACK PAGE

LOG DATA

TYPE OF LOG RUN (Circle One):
No Log Run, Electric, Gamma Ray, Density, Sonic, Neutron,
Other (Describe)

Name of Organization Running Log

SCREEN DATA

Diameter - Inches 4	Length - Feet 10'	Slot Size - Inches #10
Screen Type WRAP	Depth to Bottom - Feet 273	

GEOLOGIC DATA (Office Use Only)

Surface Elev.	Geologic Unit	Unit Thickness	Depth to Top
Subs. SWL	Date	Analysis	Aquifer Test

Driller's Remarks


RECEIVED

DESCRIPTION OF FORMATIONS ENCOUNTERED	FROM	TO	FORMATIONS (Continued)	FROM	TO
RED CLAY	0	20	MAY 11 1989 Department of Natural Resources Bureau of Land & Water Resources		
RED SAND	20	50			
BLUE CLAY	50	180			
SAND	180	200			
BLUE CLAY	200	290			
SAND	24	288			

IF MORE SPACE IS NEEDED, USE BACK

If well telescopes please sketch and show depths.

GROUND LEVEL

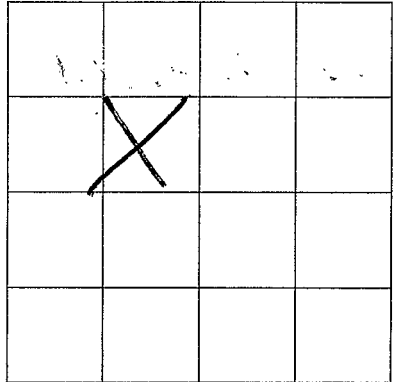

SECTION _____

Please indicate well location X.

ADDITIONAL INFORMATION

If more than one screen,
show location of each on sketch.