

MISSISSIPPI DEPARTMENT OF NATURAL RESOURCES

Bureau of Land and Water Resources

Southport Mall

P.O. Box 10631

Jackson, Mississippi 39209

WATER WELL DRILLERS LOG

P. River
 #
 2133

9/25 1989 date well completed
 B. B. Benton & Son firm name
 Pearl River county well located

LANDOWNER: <u>Butch Landry</u>	description of formations encountered	from	to
<u>PO Box 202 Carrieville</u> <u>Miss 39426</u> (mailing address)			


WELL LOCATION:
 sec. 2 T 4 N R 18 E
 S W
5 miles West of Carrieville
 (distance) (direction) (nearest town)

WELL PURPOSE: Home
 (home, irrigation, municipal, industrial)

- WELL COMPLETION DATA:
- (1) diameter (inches) 4"
 - (2) total depth (feet) 304
 - (3) static water level (feet) 130 below/above top of ground.
 - (4) casing pvc, 304
(material) (depth)
4 1/2 if telescope see back.
(size)
 - (5) screen 10, 284
(length) (depth to top)
1 1/2, pvc
(size) (material)
 - (6) pump 1, 650
(HP) (yield gpm)
Electric
(type power)
 - (7) electric log no
(yes or no)

(organization running log)
 (8) how well bottom plugged part

DRILLERS REMARKS:

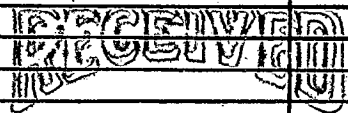


JAN 26 1990

Department of Natural Resources
 Bureau of Land & Water Resources

If well telescopes please sketch and show depths.

GROUND LEVEL

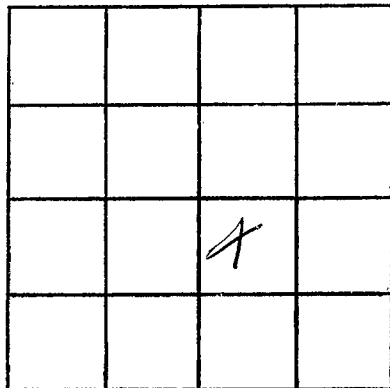

SECTION _____

Please indicate well location X.

ADDITIONAL INFORMATION

If more than one screen,
show locations of each on sketch.