

MISSISSIPPI DEPARTMENT OF NATURAL RESOURCES

Bureau of Land and Water Resources

Southport Mall

P.O. Box 10631

Jackson, Mississippi 39209

WATER WELL DRILLERS LOG

P. RIVER
 10
 2134

8/1

1989 Blueport Services Pearl River

date well completed

firm name

county well located

LANDOWNER: Butch Jackson
R.T. 1 Box Carriere
Miss.
 (mailing address)

description of formations encountered

from

to


WELL LOCATION:
 sec. 11 T. 4 N R. 18 E
 S W
7 miles W of Carriere
 (distance) (direction) (nearest town)

Red sand	0	8
Red shale	8	15
Red sand	15	40
Blue shale	40	160
Red sand	160	293
Blue shale	293	400
Grey sand	400	490

WELL PURPOSE: home
 (home, irrigation, municipal, industrial)

WELL COMPLETION DATA:

- (1) diameter (inches) 4"
- (2) total depth (feet) 490
- (3) static water level (feet) 197 below top of ground.
- (4) casing pvc 490
 (material) (depth)
4x2 if telescope see back.
 (size)
- (5) screen 10 480
 (length) (depth to top)
12 pvc
 (size) (material)
- (6) pump 1 260
 (HP) (yield gpm)
Elect
 (type power)
- (7) electric log no
 (yes or no)

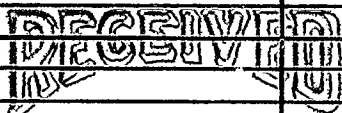

JAN 26 1990

Department of Natural Resources
 Bureau of Land & Water Resources

(organization running log)

(8) how well bottom plugged no

DRILLERS REMARKS:

