

# MISSISSIPPI DEPARTMENT OF NATURAL RESOURCES

Bureau of Land and Water Resources

COUNTY WELL LOCATED <b>PEARL RIVER</b>	
WELL NUMBER <b>0</b>	CODED
<b>2135</b>	
DATE WELL COMPLETED <b>1-12-90</b>	

PERMIT NUMBER <b>0-477</b>
NAME OF DRILLING FIRM <b>PENTON WELL SERV</b>
<b>Nicholson, MS.</b>

P.O. Box 10631  
Jackson, Mississippi 39209  
WATER WELL DRILLERS LOG

NAME & MAILING ADDRESS OF LANDOWNER <b>Charles Reed Jones</b>			
<b>Rt. 1 Box 265-B</b>			
<b>CARRIERS, MS. 39426</b>			
WELL LOCATION:	SEC	TOWNSHIP	RANGE
	<b>26</b>	<b>4 S</b>	<b>18 W</b>
DISTANCE	DIRECTION	NEAREST TOWN	
<b>1</b> Miles	<b>5</b>	<b>Henleyfield</b>	
OTHER LANDMARK <b>1 mile S. of PineTuckey Church</b>			
WELL PURPOSE: Home, Irrigation, Municipal, Industrial, Fish Pond, etc.			

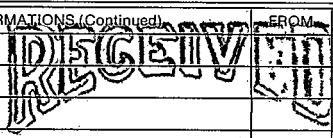
<b>PUMP DATA</b>		
PUMP TYPE (Circle One): <b>Submersible</b> , Turbine, Jet, Flowing Well, Other (Describe) _____		
POWER TYPE (Circle One): <b>Electric</b> , Tractor, Diesel, Gasoline, Butane, Other (Describe) _____		
Pump Capacity (GPM)	No. of Stages	Setting Depth  <b>FT.</b>
PUMP TEST		
Well yielded _____ GPM with a drawdown of _____ ft. after _____ hours of pumping		

<b>WELL DATA</b>		
Well Depth <b>346'</b>	Casing Diameter (In.) <b>4 x 2</b>	Casing Length (Ft.) <b>331</b>
Type of Casing <b>PVC</b>	Hole Depth <b>346'</b>	Depth to Static Water Level <b>115'</b>
TYPE OF COMPLETION: (Circle One or More): <b>Natural Development</b> , Gravel Packed, Underreamed, Telescoped, Open Hole, Other		
Top of Lap Pipe or Reduction in Casing <b>260 FEET</b>		
IF TELESCOPED OR MORE THAN ONE SCREEN: USE BACK PAGE		

<b>LOG DATA</b>	
TYPE OF LOG RUN (Circle One): <b>No Log Run</b> , Electric, Gamma Ray, Density, Sonic, Neutron, Other (Describe) _____	
Name of Organization Running Log	

<b>SCREEN DATA</b>		
Diameter - Inches <b>2</b>	Length - Feet <b>15</b>	Slot Size - Inches <b>28-010</b>
Screen Type <b>PVC</b>	Depth to Bottom - Feet <b>346</b>	

<b>GEOLOGIC DATA (Office Use Only)</b>			
Surface Elev.	Geologic Unit	Unit Thickness	Depth to Top
Subs. SWL	Date	Analysis	Aquifer Test

DESCRIPTION OF FORMATIONS ENCOUNTERED	FROM	TO	FORMATIONS (Continued)	FROM	TO
<b>CLAY</b>	<b>0</b>	<b>15</b>	 <b>FEB 1 1990</b> Department of Natural Resources Bureau of Land & Water Resources		
<b>Red SAND</b>	<b>15</b>	<b>85</b>			
<b>CLAY</b>	<b>85</b>	<b>160</b>			
<b>SILT</b>	<b>160</b>	<b>183</b>			
<b>CLAY</b>	<b>183</b>	<b>280</b>			
<b>SAND</b>	<b>280</b>	<b>346</b>			

IF MORE SPACE IS NEEDED, USE BACK

If well telescopes please sketch and show depths.

GROUND LEVEL



		X	

SECTION 26

Please indicate well location X.

ADDITIONAL INFORMATION

If more than one screen,  
show location of each on sketch.