

MISSISSIPPI DEPARTMENT OF NATURAL RESOURCES

Bureau of Land and Water Resources

P.O. Box 10631

Jackson, Mississippi 39209

WATER WELL DRILLERS LOG

COUNTY WELL LOCATED <i>Pearl River</i>	
WELL NUMBER <i>Φ</i>	CODED
<i>2138</i>	
DATE WELL COMPLETED <i>1-7-90</i>	

PERMIT NUMBER <i>0-519</i>
NAME OF DRILLING FIRM <i>Walker's Well Service</i>

NAME & MAILING ADDRESS OF LANDOWNER <i>Wayne Mitchell</i>			
<i>Rt. 1 Caniere, Mo.</i>			
<i>39426</i>			
WELL LOCATION: SEC	TOWNSHIP	RANGE	
<i>39</i>	<i>4</i>	<i>N 18 E</i>	
DISTANCE	DIRECTION	NEAREST TOWN	
<i>15</i> Miles	<i>North</i>	<i>Prayune</i>	
OTHER LANDMARK <i>game reserve</i>			
WELL PURPOSE: <i>Home, Irrigation, Municipal, Industrial, Fish Pond, etc.</i>			

PUMP DATA		
PUMP TYPE (Circle One): Submersible, Turbine, Jet <i>Flowing Well</i> Other (Describe) _____		
POWER TYPE (Circle One): Electric, Tractor, Diesel, Gasoline, Butane, Other (Describe) _____ H/P _____		
Pump Capacity (GPM)	No. of Stages	Setting Depth
		FT.
PUMP TEST		
Well yielded _____ GPM with		
a drawdown of _____ ft.		
after _____ hours of pumping		

WELL DATA		
Well Depth <i>695</i>	Casing Diameter (In.) <i>4</i>	Casing Length (Ft.) <i>675</i>
Type of Casing <i>PVC</i>	Hole Depth <i>695</i>	Depth to Static Water Level <i>0</i>
TYPE OF COMPLETION: (Circle One or More): Gravel Packed, Underreamed, Telescoped, <i>Natural Development</i> , Open Hole, Other (Describe) <i>an crosswash</i>		
Top of Lap Pipe or Reduction in Casing		
FEET IF TELESCOPED OR MORE THAN ONE SCREEN: USE BACK PAGE		

LOG DATA	
TYPE OF LOG RUN (Circle One): No Log Run, Electric, Gamma Ray, Density, Sonic, Neutron, Other (Describe) _____	
Name of Organization Running Log	

SCREEN DATA		
Diameter - Inches <i>4</i>	Length - Feet <i>20</i>	Slot Size - Inches <i>#12</i>
Screen Type <i>J-wrap</i>	Depth to Bottom - Feet <i>695</i>	


GEOLOGIC DATA (Office Use Only)			
Surface Elev.	Geologic Unit	Unit Thickness	Depth to Top
Subs. SWL	Date	Analysis	Acquifer Test
RECEIVED			
FEB 15 1990			
Department of Natural Resources Bureau of Land & Water Resources			

DESCRIPTION OF FORMATIONS ENCOUNTERED	FROM	TO	FORMATIONS (Continued)	FROM	TO
<i>Black dirt</i>	<i>0</i>	<i>15</i>	<i>sand</i>	<i>420</i>	<i>490</i>
<i>white clay</i>	<i>15</i>	<i>25</i>	<i>blue clay</i>	<i>490</i>	<i>520</i>
<i>sand</i>	<i>25</i>	<i>65</i>	<i>brown clay</i>	<i>520</i>	<i>610</i>
<i>Blue clay</i>	<i>65</i>	<i>105</i>	<i>blue clay</i>	<i>610</i>	<i>660</i>
<i>sand white clay</i>	<i>105</i>	<i>165</i>	<i>sand</i>	<i>660</i>	<i>695</i>
<i>Blue clay</i>	<i>165</i>	<i>175</i>			
<i>trash pile sticks</i>	<i>175</i>	<i>185</i>			
<i>Black dirt</i>	<i>185</i>	<i>205</i>			
<i>Blue Clay</i>	<i>205</i>	<i>305</i>			
<i>fine sand</i>	<i>305</i>	<i>420</i>			

IF MORE SPACE IS NEEDED, USE BACK

If well telescopes please sketch and show depths.

GROUND LEVEL

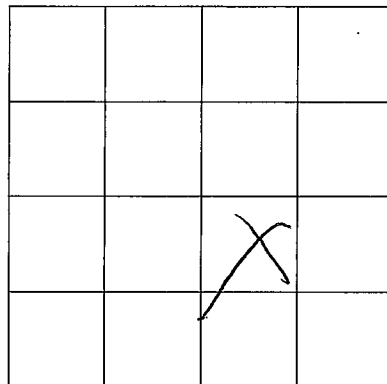

SECTION _____

Please indicate well location X.

ADDITIONAL INFORMATION

If more than one screen,
show location of each on sketch.