

# MISSISSIPPI DEPARTMENT OF NATURAL RESOURCES

Bureau of Land and Water Resources

P.O. Box 10631

Jackson, Mississippi 39209

## WATER WELL DRILLERS LOG

COUNTY WELL LOCATED <b>Pearl River</b>	
WELL NUMBER <b>Φ</b>	CODED
DATE WELL COMPLETED <b>2/4/90</b> <b>3-2-90</b>	

PERMIT NUMBER <b>0-519</b>
NAME OF DRILLING FIRM <b>Walters Well Service</b>

NAME & MAILING ADDRESS OF LANDOWNER <b>Jeff Denton</b>			
<b>Field of Flower Plants</b>			
<b>Henleyfield, MS.</b>			
WELL LOCATION: SECTION	TOWNSHIP	RANGE	
<b>23</b>	<b>4</b>	<b>N 18 E</b>	
DISTANCE	DIRECTION	NEAREST TOWN	
<b>15</b> Miles	<b>North</b>	<b>Picayune</b>	
OTHER LANDMARK <b>Greenhouse on Lake Smith Rd</b>			
WELL PURPOSE: Home, Irrigation, Municipal, Industrial, Fish Pond, etc.			

PUMP DATA		
PUMP TYPE (Circle One): <input checked="" type="checkbox"/> Submersible, Turbine, Jet, Flowing Well, Other (Describe) _____		
POWER TYPE (Circle One): <input checked="" type="checkbox"/> Electric, Tractor, Diesel, Gasoline, Butane, Other (Describe) _____ H/P _____		
Pump Capacity (GPM)	No. of Stages	Setting Depth
<b>60</b>	<b>13</b>	<b>160</b> FT.
PUMP TEST		
Well yielded _____ <b>60</b> GPM with a drawdown of _____ <b>20</b> ft. after _____ <b>12</b> hours of pumping		

WELL DATA		
Well Depth	Casing Diameter (In.)	Casing Length (Ft.)
<b>470</b>	<b>4</b>	<b>450</b>
Type of Casing	Hoile Depth	Depth to Static Water Level
<b>PVC</b>	<b>470</b>	<b>100</b>
TYPE OF COMPLETION: (Circle One or More): Gravel Packed, Underreamed, Telescoped, Natural Development, Open Hole, Other (Describe) _____		
Top of Lap Pipe or Reduction in Casing		
FEET <input type="checkbox"/> IF TELESCOPED OR MORE THAN ONE SCREEN: USE BACK PAGE		

LOG DATA	
TYPE OF LOG RUN (Circle One): <input type="checkbox"/> No Log Run, Electric, Gamma Ray, Density, Sonic, Neutron, Other (Describe) _____	
Name of Organization Running Log	


SCREEN DATA		
Diameter - Inches	Length - Feet	Slot Size - Inches
<b>4</b>	<b>20</b>	<b>#12</b>
Screen Type	Depth to Bottom - Feet	
<b>Slot</b>	<b>470</b>	

GEOLOGIC DATA (Office Use Only)			
Surface Elev.	Geologic Unit	Unit Thickness	Depth to Top
Subs. SWL	Date	Analysis	Aquifer Test
Driller's Remarks			

DESCRIPTION OF FORMATIONS ENCOUNTERED	FROM	TO	FORMATIONS (Continued)
<b>red clay</b>	<b>0</b>	<b>20</b>	<div style="font-size: 2em; font-weight: bold; opacity: 0.5;">RECEIVED</div> <div style="font-size: 1.5em; font-weight: bold; margin-top: 10px;">MAY 25 1990</div> <div style="font-size: 0.8em; margin-top: 10px;">                     Department of Natural Resources                      Bureau of Land &amp; Water Resources                 </div>
<b>pink sand</b>	<b>20</b>	<b>50</b>	
<b>rocks &amp; clay</b>	<b>50</b>	<b>70</b>	
<b>white clay</b>	<b>70</b>	<b>90</b>	
<b>blue clay</b>	<b>90</b>	<b>200</b>	
<b>sand</b>	<b>200</b>	<b>220</b>	
<b>blue clay</b>	<b>220</b>	<b>370</b>	
<b>sand fine</b>	<b>370</b>	<b>395</b>	
<b>fine sand</b>	<b>395</b>	<b>420</b>	
<b>course sand</b>	<b>420</b>	<b>470</b>	
IF MORE SPACE IS NEEDED, USE BACK			

If well telescopes please sketch and show depths.

GROUND LEVEL

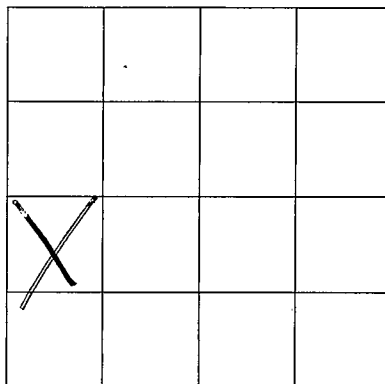

SECTION \_\_\_\_\_

Please indicate well location X.

ADDITIONAL INFORMATION

USED TO WATER SMALL  
PLANTS IN GREEN HOUSE

If more than one screen,  
show location of each on sketch.