

MISSISSIPPI DEPARTMENT OF NATURAL RESOURCES

Bureau of Land and Water Resources

P.O. Box 10631
Jackson, Mississippi 39209
WATER WELL DRILLERS LOG

COUNTY WELL LOCATED Pearl River	
WELL NUMBER Φ	CODED
2142	
DATE WELL COMPLETED 3-5-90	

PERMIT NUMBER 0-519
NAME OF DRILLING FIRM Walkers Well Service

NAME & MAILING ADDRESS OF LANDOWNER DAVIS MIKE		
R+1 CAREY BYRD RD.		
WELL LOCATION: SE 12 TOWNSHIP 4 RANGE		
Q	NORTH	16 E
DISTANCE 14 Miles	DIRECTION NORTH	NEAREST TOWN PICAYUNE
OTHER LANDMARK Carey Byrd Road		
WELL PURPOSE: <input checked="" type="checkbox"/> Home Irrigation, <input type="checkbox"/> Municipal, <input type="checkbox"/> Industrial, <input type="checkbox"/> Fish Pond, etc.		

PUMP DATA		
PUMP TYPE (Circle One): Submersible, Turbine, Sur Flowing Well, Other (Describe) _____		
POWER TYPE (Circle One): Electric Tractor, Diesel, Gasoline, Butane, Other (Describe) _____ H/P _____		
Pump Capacity (GPM)	No. of Stages	Setting Depth FT.
PUMP TEST		
Well yielded _____ GPM with a drawdown of _____ ft. after _____ hours of pumping		

WELL DATA		
Well Depth 95	Casing Diameter (In.) 2	Casing Length (Ft.) 85
Type of Casing PVC	Hole Depth 95	Depth to Static Water Level 50
TYPE OF COMPLETION: (Circle One or More): <input checked="" type="checkbox"/> Gravel Packed, <input type="checkbox"/> Underreamed, <input type="checkbox"/> Telescoped, <input type="checkbox"/> Natural Development, <input type="checkbox"/> Open Hole, <input type="checkbox"/> Other (Describe) _____		
Top of Lap Pipe or Reduction in Casing FEET <input type="checkbox"/> IF TELESCOPED OR MORE THAN ONE SCREEN: USE BACK PAGE		

LOG DATA	
TYPE OF LOG RUN (Circle One): No Log Run, Electric, Gamma Ray, Density, Sonic, Neutron, Other (Describe) _____	
Name of Organization Running Log	

SCREEN DATA		
Diameter - Inches 2	Length - Feet 10	Slot Size - Inches #12
Screen Type Slot	Depth to Bottom - Feet 95	


GEOLOGIC DATA (Office Use Only)			
Surface Elev.	Geologic Unit	Unit Thickness	Depth to Top
Subs. SWL	Date	Analysis	Aquifer Test
Driller's Remarks			

DESCRIPTION OF FORMATIONS ENCOUNTERED	FROM	TO	FORMATIONS (continued)	FROM	TO
Black dirt	0	15	<div style="border: 2px solid black; padding: 5px; display: inline-block;"> PROVIDED MAY 25 1990 Department of Natural Resources Bureau of Land & Water Resources </div>		
white clay	15	25			
sand	25	45			
clay	45	60			
sand & rocks	60	95			

IF MORE SPACE IS NEEDED, USE BACK

If well telescopes please sketch and show depths.

GROUND LEVEL

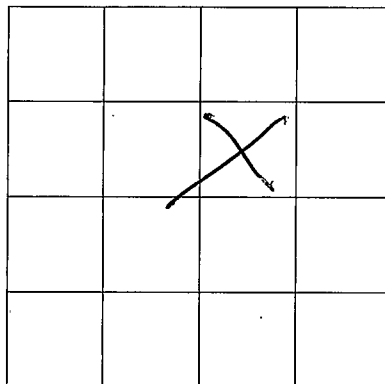

SECTION _____

Please indicate well location X.

ADDITIONAL INFORMATION

If more than one screen,
show location of each on sketch.