

MISSISSIPPI DEPARTMENT OF NATURAL RESOURCES

Bureau of Land and Water Resources

P.O. Box 10631

Jackson, Mississippi 39209

WATER WELL DRILLERS LOG

COUNTY WELL LOCATED Pearl River	
WELL NUMBER Φ	CODED
2145	
DATE WELL COMPLETED 6-10-90	

PERMIT NUMBER 0-519
NAME OF DRILLING FIRM Walker Well Drilling

NAME & MAILING ADDRESS OF LANDOWNER Norman West Rt. 1 Cypress Hill Farm			
WELL LOCATION: SEC	TOWNSHIP	RANGE	
17	4	18	E
DISTANCE	DIRECTION	NEAREST TOWN	
12 Miles	South	of Perreune	
OTHER LANDMARK Cypress Curve			
WELL PURPOSE: Home, Irrigation, Municipal, Industrial, Fish Pond, etc.			

PUMP DATA			
PUMP TYPE (Circle One): <input checked="" type="radio"/> Submersible, Turbine, Jet, Flowing Well, Other (Describe) _____			
POWER TYPE (Circle One): <input checked="" type="radio"/> Electric, Tractor, Diesel, Gasoline, Butane, Other (Describe) _____ H/P _____			
Pump Capacity (GPM) 18	No. of Stages 8	Setting Depth 80 FT.	
PUMP TEST			
Well yielded _____ GPM with a drawdown of _____ ft. after _____ hours of pumping			

WELL DATA		
Well Depth 240'	Casing Diameter (In.) 4"	Casing Length (Ft.) 230
Type of Casing PVC	Hole Depth 240	Depth to Static Water Level 20
TYPE OF COMPLETION: (Circle One or More): <input checked="" type="checkbox"/> Gravel Packed, <input type="checkbox"/> Underreamed, <input type="checkbox"/> Telescoped, <input checked="" type="checkbox"/> Natural Development, <input type="checkbox"/> Open Hole, <input type="checkbox"/> Other (Describe) Air		
Top of Lap Pipe or Reduction in Casing FEET IF TELESCOPED OR MORE THAN ONE SCREEN: USE BACK PAGE		

LOG DATA	
TYPE OF LOG RUN (Circle One): <input type="checkbox"/> No Log Run, <input type="checkbox"/> Electric, <input type="checkbox"/> Gamma Ray, <input type="checkbox"/> Density, <input type="checkbox"/> Sonic, <input type="checkbox"/> Neutron, Other (Describe) _____	
Name of Organization Running Log	

SCREEN DATA		
Diameter - Inches 4	Length - Feet 10'	Slot Size - Inches #10
Screen Type slot	Depth to Bottom - Feet 240	


GEOLOGIC DATA (Office Use Only)			
Surface Elev.	Geologic Unit	Unit Thickness	Depth to Top
Subs. SWL	Date	Analysis	Aquifer Test
Driller's Remarks			

DESCRIPTION OF FORMATIONS ENCOUNTERED	FROM	TO	FORMATIONS (Continued)	FROM	TO
Black dirt	0	10	RECEIVED AUG 14 1990 Department of Natural Resources Bureau of Land & Water Resources		
Clay white	10	20			
Sand	20	60			
Blue Clay	60	160			
Sand fine	160	180			
Coarse Sand	180	240			

IF MORE SPACE IS NEEDED, USE BACK

If well telescopes please sketch and show depths.

GROUND LEVEL

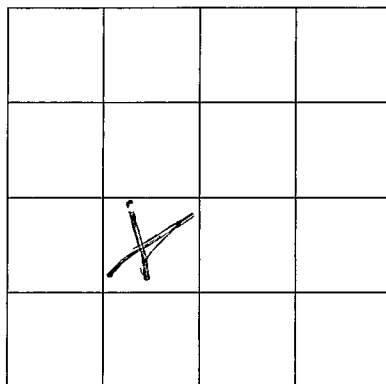

SECTION _____

Please indicate well location X.

ADDITIONAL INFORMATION

If more than one screen,
show location of each on sketch.