

P. River
Φ 2146

MISSISSIPPI DEPARTMENT OF NATURAL RESOURCES

Bureau of Land and Water Resources

Southport Mall

P.O. Box 10631

Jackson, Mississippi 39209

WATER WELL DRILLERS LOG

7/20

date well completed

1990 Bud Perton

firm name

Pearl River

county well located

LANDOWNER:

Charlie Dugdale

description of formations encountered

from

to

R-T-1 Box 248

Red shale

0 15

Carriere Miss.

Red sand

15 35

(mailing address)

Blue shale

35 125

White sand

125 148

WELL LOCATION:

sec. B-T-4 N R-18 E
S W
8 miles W Carriere
(distance) (direction) (nearest town)

WELL PURPOSE: none
(home, irrigation, municipal, industrial)

WELL COMPLETION DATA:

- (1) diameter (inches) 2"
- (2) total depth (feet) 148
- (3) static water level (feet) 81 below above top of ground.
- (4) casing pvc 148
(material) (depth)

(size) If telescope see back.

- (5) screen 10 138
(length) (depth to top)

10 pvc
(size) (material)

- (6) pump 1 35
(HP) (yield gpm)

Elect
(type power)

- (7) electric log no
(yes or no)

(organization running log)

- (8) how well bottom plugged Sand
Shore

DRILLERS REMARKS:


RECEIVED
RIS

OCT 15 1990

Department of Natural Resources
Bureau of Land & Water Resources

If well telescopes please sketch and show depths.

GROUND LEVEL

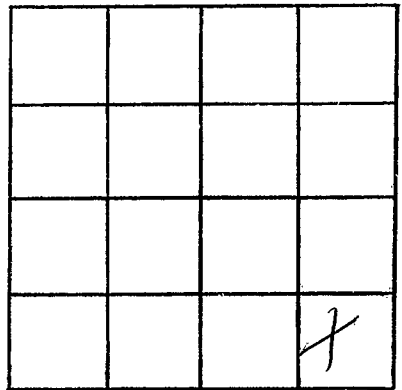

SECTION _____

Please indicate well location X.

ADDITIONAL INFORMATION

If more than one screen,
show locations of each on sketch.