

MISSISSIPPI DEPARTMENT OF NATURAL RESOURCES
Bureau of Land and Water Resources
 Southport Mall
 P.O. Box 10631
 Jackson, Mississippi 39209
WATER WELL DRILLERS LOG

Pearl River
Φ 2152

2/21 19 Bud Denton Pearl River
 date well completed firm name county well located


LANDOWNER: Clark Moss
Hwy. 43 North Carriere
MS 39426
 (mailing address)

description of formations encountered	from	to
<u>Red shale</u>	<u>0</u>	<u>20</u>
<u>Red sand</u>	<u>20</u>	<u>85</u>

WELL LOCATION:
 sec 23 T 4 N R 18 E
8 miles West of Carriere
 (distance) (direction) (nearest town)

WELL PURPOSE: home
 (home, irrigation, municipal, industrial)

- WELL COMPLETION DATA:
- (1) diameter (inches) 2"
 - (2) total depth (feet) 85
 - (3) static water level (feet) 36 below above top of ground.
 - (4) casing PVC, 85,
 (material) (depth)
 (size) if telescope see back.
 - (5) screen 5, 80
 (length) (depth to top)
1/2, PVC
 (size) (material)
 - (6) pump 1/2 450
 (HP) (yield gpm)
Elect
 (type power)
 - (7) electric log no
 (yes or no)
 - (organization running log)
 - (8) how well bottom plugged hard sharp

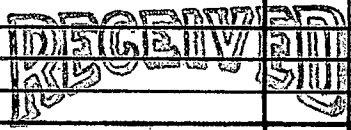


APR 29 1991

Dept. of Environmental Quality
 Bureau of Land & Water Resources

DRILLERS REMARKS:

If well telescopes please sketch and show depths.

GROUND LEVEL

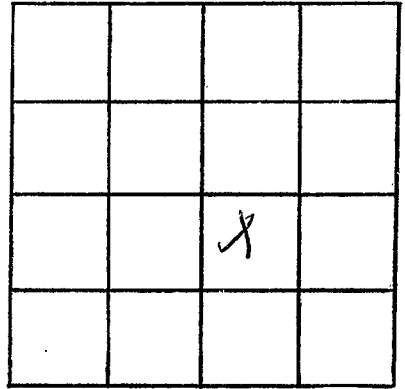

SECTION 23

Please indicate well location X.

ADDITIONAL INFORMATION

If more than one screen,
show locations of each on sketch.