

MISSISSIPPI DEPARTMENT OF ENVIRONMENTAL QUALITY
Bureau of Land and Water Resources

P. O. Box 10631
Jackson, MS 39289-0631
WATER WELL DRILLERS LOG

COUNTY & WELL LOCATED <i>Pearl River</i>	
WELL NUMBER <i>2153</i>	CODED
DATE WELL COMPLETED <i>1-8-92</i>	

PERMIT NUMBER <i>0-519</i>
NAME OF DRILLING FIRM <i>Walkers Well Service</i>

NAME & MAILING ADDRESS OF LANDOWNER <i>Richard G. Thomas</i> <i>RTICARREIER MS</i>		
WELL LOCATION: SEC <i>27</i> TOWNSHIP <i>4 N</i> RANGE <i>18 E</i>		
DISTANCE <i>16</i> Miles	DIRECTION <i>NORTH</i>	NEAREST TOWN <i>Pearl River</i>
OTHER LANDMARK <i>Ray Dory LAKE</i>		
WELL PURPOSE: <i>Home</i> Irrigation, Municipal, Industrial, Fish Pond, etc.		

PUMP DATA		
PUMP TYPE (Circle One): Submersible, Turbine, Jet, Flowing Well, Other (Describe) _____		
POWER TYPE (Circle One): Electric, Tractor, Diesel, Gasoline, Butane, Other (Describe) _____ H/P _____		
Pump Capacity (GPM)	No. of Stages	Setting Depth FT.
PUMP TEST Well yielded _____ GPM with a drawdown of _____ ft. after _____ hours of pumping		

WELL DATA		
Well Depth <i>60</i>	Casing Diameter (In.) <i>2</i>	Casing Length (Ft.) <i>50</i>
Type of Casing <i>PVC</i>	Hole Depth <i>60</i>	Depth to Static Water Level <i>20</i>
TYPE OF COMPLETION: (Circle One or More): <input checked="" type="checkbox"/> Gravel Packed, <input type="checkbox"/> Underreamed, <input type="checkbox"/> Telescoped, <input checked="" type="checkbox"/> Natural Development, <input type="checkbox"/> Open Hole, <input type="checkbox"/> Other (Describe) _____		
Top of Lap Pipe or Reduction in Casing FEET IF TELESCOPED OR MORE THAN ONE SCREEN: USE BACK PAGE		

LOG DATA	
TYPE OF LOG RUN (Circle One): No Log Run, Electric, Gamma-Ray, Density, Sonic, Neutron, Other (Describe) _____	
Name of Organization Running Log	

SCREEN DATA		
Diameter - Inches <i>2</i>	Length - Feet <i>10</i>	Slot Size - Inches <i>12</i>
Screen Type <i>Slot</i>	Depth to Bottom - Feet <i>60</i>	

GEOLOGIC DATA (Office Use Only)			
Surface Elev.	Geologic Unit	Unit Thickness	Depth to Top
Subs. SWL	Date	Analysis	Aquifer Test
Driller's Remarks			


DESCRIPTION OF FORMATIONS ENCOUNTERED	FROM	TO
<i>red clay</i>	<i>0</i>	<i>10</i>
<i>white clay</i>	<i>10</i>	<i>20</i>
<i>sand</i>	<i>20</i>	<i>50</i>
<i>rocks</i>	<i>50</i>	<i>60</i>

FORMATIONS (Continued)	FROM	TO
RECEIVED		
APR 17 1992		
Dept. of Environmental Quality Bureau of Land & Water Resources		

IF MORE SPACE IS NEEDED, USE BACK

If well telescopes please
sketch and show depths.

GROUND LEVEL

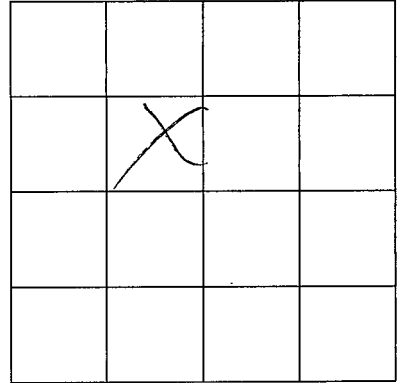

SECTION _____

Please indicate well location X.

ADDITIONAL INFORMATION

If more than one screen,
show location of each on sketch.