

MISSISSIPPI DEPARTMENT OF ENVIRONMENTAL QUALITY
Bureau of Land and Water Resources

P. O. Box 10631
Jackson, MS 39289-0631
WATER WELL DRILLERS LOG

COUNTY WELL LOCATED PEARL RIVER	
WELL NUMBER Q	CODED
2155	
DATE WELL COMPLETED 1-7-92	

PERMIT NUMBER 0-519
NAME OF DRILLING FIRM WALKER'S WELL SERVICE

NAME & MAILING ADDRESS OF LANDOWNER SCOTTY SULLIVAN Rt 1 PARRIERE MS			
WELL LOCATION: SEC	TOWNSHIP	RANGE	
23	4	N 18 E	
DISTANCE	DIRECTION	NEAREST TOWN	
15 Miles	NORTH	of POCAYUNE	
OTHER LANDMARK Hwy 43 NORTH			
WELL PURPOSE: Home Irrigation, Municipal, Industrial, Fish Pond, etc.			

PUMP DATA			
PUMP TYPE (Circle One): <u>Submersible</u> , Turbine, Jet, Flowing Well, Other (Describe) _____			
POWER TYPE (Circle One): Electric, Tractor, Diesel, Gasoline, Butane, Other (Describe) _____ H/P _____			
Pump Capacity (GPM)	No. of Stages	Setting Depth	
20	8	75 FT.	
PUMP TEST			
Well yielded _____ GPM with a drawdown of _____ ft. after _____ hours of pumping			

WELL DATA			
Well Depth 90	Casing Diameter (In.) 4	Casing Length (Ft.) 90	
Type of Casing PVC	Hole Depth 90	Depth to Static Water Level 40	
TYPE OF COMPLETION: (Circle One or More): Gravel Packed, Underreamed, Telescoped, <u>Natural Development</u> , Open Hole, Other (Describe) _____			
Top of Lap Pipe or Reduction in Casing FEET IF TELESCOPED OR MORE THAN ONE SCREEN: USE BACK PAGE			

LOG DATA	
TYPE OF LOG RUN (Circle One): No Log Run, Electric, Gamma Ray, Density, Sonic, Neutron, Other (Describe) _____	
Name of Organization Running Log	

SCREEN DATA		
Diameter - Inches 4	Length - Feet 10	Slot Size - Inches #12
Screen Type SLOT		Depth to Bottom - Feet 90


GEOLOGIC DATA (Office Use Only)			
Surface Elev.	Geologic Unit	Unit Thickness	Depth to Top
Subs. SWL	Date	Analysis	Aquifer Test
Driller's Remarks			

DESCRIPTION OF FORMATIONS ENCOUNTERED	FROM	TO	FORMATIONS (Continued)	FROM	TO
RED CLAY	0	10	RECEIVED APR 17 1992 Dept. of Environmental Quality Bureau of Land & Water Resources		
WHITE CLAY	10	35			
SAND	35	65			
ROCK	65	75			
SAND	75	90			

IF MORE SPACE IS NEEDED, USE BACK

If well telescopes please
sketch and show depths.

GROUND LEVEL

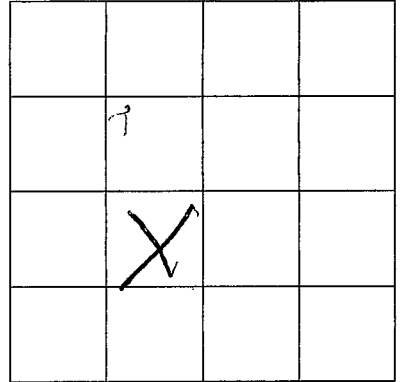

SECTION _____

Please indicate well location X.

ADDITIONAL INFORMATION

If more than one screen,
show location of each on sketch.