

MISSISSIPPI DEPARTMENT OF NATURAL RESOURCES

Bureau of Land and Water Resources

Southport Mall

P.O. Box 10631

Jackson, Mississippi 39209

WATER WELL DRILLERS LOG

Pearl River
Φ
2130

3/24-92
 date well completed

Bud Denton
 firm name

Pearl River
 county well located

LANDOWNER: Stel Skippen
line 43 north
 (mailing address)

description of formations encountered	from	to
Red shale	0	10
Red sand	10	87
Blue shale	87	240
Blue sand	240	420
Blue shale	420	468
Blue sand	468	520
Blue shale	520	630
Gray sand	630	690

WELL LOCATION:
 sec. 11 T 4 N R. 18 E
 S W W
6 miles W of Carriere
 (distance) (direction) (nearest town)

WELL PURPOSE: private
 (home, irrigation, municipal, industrial)


WELL COMPLETION DATA:

- (1) diameter (inches) 4"
- (2) total depth (feet) 690
- (3) static water level (feet) 54 below top of ground.
- (4) casing PVC, 690
 (material) (depth)
- 4x2 if telescope see back.
 (size)
- (5) screen 10, 680
 (length) (depth to top)
- 12, PVC
 (size) (material)
- (6) pump 1, 20
 (HP) (yield gpm)
- East
 (type power)
- (7) electric log no
 (yes or no)

(organization running log)

(8) how well bottom plugged land
shale

DRILLERS REMARKS:

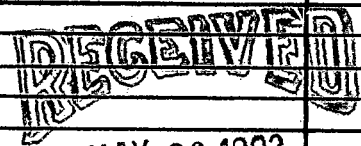

MAY 26 1992

Dept. of Environmental Quality
 Bureau of Land & Water Resources

