

MISSISSIPPI DEPARTMENT OF NATURAL RESOURCES

Bureau of Land and Water Resources

Southport Mall

P.O. Box 10631

Jackson, Mississippi 39209

WATER WELL DRILLERS LOG

Pearl River
0215T

3/21-92 19 Bed Penton & Son Pearl River
 date well completed firm name county well located

LANDOWNER: Clark Moss

NW 4-3 north

description of formations encountered	from	to
<u>Red shale</u>	<u>0</u>	<u>20</u>
<u>Red sand</u>	<u>20</u>	<u>84</u>

(mailing address)

WELL LOCATION:

sec. 24 T. 4 N R. 18 E
6 miles N of Carriere
 (distance) (direction) (nearest town)

WELL PURPOSE: home
 (home, irrigation, municipal, industrial)

WELL COMPLETION DATA:

- (1) diameter (inches) 2"
- (2) total depth (feet) 84
- (3) static water level (feet) 36 below above top of ground.
- (4) casing pvc 80
 (material) (depth)

(size) if telescope see back.

- (5) screen 5' 80
 (length) (depth to top)
- 12 pvc
 (size) (material)
- (6) pump 1/2 330
 (HP) (yield gpm)


(type power)

- (7) electric log Elect.
 (yes or no)

(organization running log)

- (8) how well bottom plugged Sand

DRILLERS REMARKS: Shark

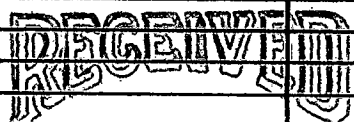


MAY 26 1992

Dept. of Environmental Quality
 Bureau of Land & Water Resources

If well telescopes please
sketch and show depths.

GROUND LEVEL

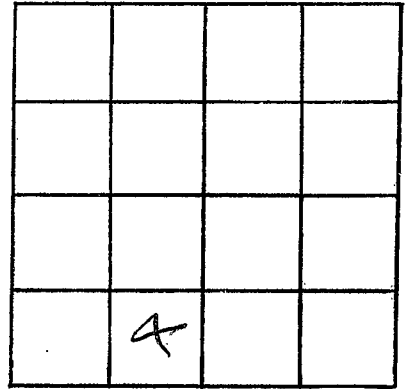

SECTION _____

Please indicate well location X.

ADDITIONAL INFORMATION

If more than one screen,
show locations of each on sketch.