

MISSISSIPPI DEPARTMENT OF NATURAL RESOURCES

Bureau of Land and Water Resources

Southport Mall

P.O. Box 10631

Jackson, Mississippi 39209

WATER WELL DRILLERS LOG

Paul River  
 # 2159

4/14 date well completed      1992 Bud Denton firm name      Paul River county well located

LANDOWNER: Jim Dixon  
Lacey Wise Rd  
1744 Carrier  
 (mailing address)

description of formations encountered	from	to
<u>Red shale</u>	<u>0</u>	<u>15</u>
<u>Red sand</u>	<u>15</u>	<u>30</u>
<u>Blue shale</u>	<u>30</u>	<u>210</u>
<u>Blue sand</u>	<u>210</u>	<u>285</u>
<u>Blue shale</u>	<u>285</u>	<u>400</u>
<u>Gray sand</u>	<u>400</u>	<u>592</u>


WELL LOCATION:  
 sec. B T. 4 N. R. 18 E  
8 miles W of Carrier  
 (distance) (direction) (nearest town)

WELL PURPOSE:  
 (home, irrigation, municipal, industrial)

WELL COMPLETION DATA:

- (1) diameter (inches) 4.592
- (2) total depth (feet) 592
- (3) static water level (feet) \_\_\_\_\_ below/above-top of ground.
- (4) casing pvc 392  
 (material) (depth)  
4 1/2 If telescope see back.  
 (size)
- (5) screen 10 582  
 (length) (depth to top)  
12 pvc  
 (size) (material)
- (6) pump 1 22  
 (HP) (yield gpm)  
Elect  
 (type power)
- (7) electric log no  
 (yes or no)
- (8) how well bottom plugged hard  
sharp

DRILLERS REMARKS:

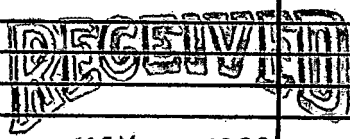

MAY 26 1992


Dept. of Environmental Quality  
 Bureau of Land & Water Resources

If well telescopes please sketch and show depths.

GROUND LEVEL

180 ft. 4"  
400 ft. 2"

If more than one screen, show locations of each on sketch.

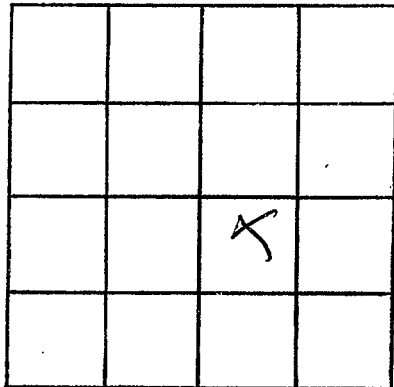

SECTION \_\_\_\_\_

Please indicate well location X.

ADDITIONAL INFORMATION

Multiple horizontal lines for additional information.