




If well telescopes please sketch and show depths.

GROUND LEVEL

200ft - 4" |  
266 - 2' |

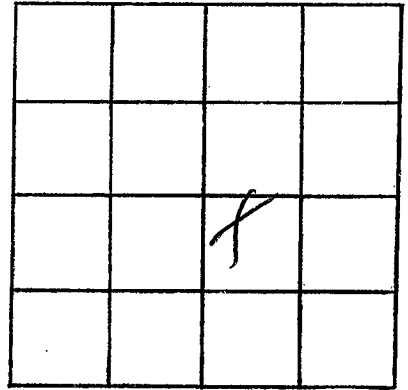

SECTION \_\_\_\_\_

Please indicate well location X.

ADDITIONAL INFORMATION

If more than one screen,  
show locations of each on sketch.