

MISSISSIPPI DEPARTMENT OF NATURAL RESOURCES

Bureau of Land and Water Resources

Southport Mall

P.O. Box 10631

Jackson, Mississippi 39209

WATER WELL DRILLERS LOG

P. River
 (P 216)

8-6 19 92 Bud Penton Water Well Pearl River
 date well completed firm name county well located

LANDOWNER: Robby Hancock
 204 1, BOX 214 CARRIERS MS 39454
 Carey Bird Rd.
 (mailing address)


description of formations encountered	from	to
red CLAY	0	16
red SAND	16	192
red CLAY	192	205
gray SAND	205	321
blue CLAY	321	440
GRAY SAND	440	525

WELL LOCATION:
 sec. 19 T. 4 N R. 18 E
 S W
2 miles west of Millcreek
 (distance) (direction) (nearest town)

WELL PURPOSE:
 (home, irrigation, municipal, industrial)

WELL COMPLETION DATA:

- (1) diameter (inches) 7
- (2) total depth (feet) 525
- (3) static water level (feet) 118 ^{below} above top of ground.
- (4) casing PVC, 515
 (material) (depth)
4x2" If telescope see back.
 (size)
- (5) screen 10', 515
 (length) (depth to top)
2", PVC
 (size) (material)
- (6) pump 1, 8
 (HP) (yield gpm)
electric
 (type power)
- (7) electric log NO
 (yes or no)
 (organization running log)
- (8) how well bottom plugged Sandshark

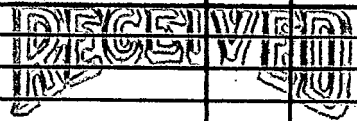

AUG 19 1992

DRILLERS REMARKS:

Dept. of Environmental Quality
 Bureau of Land & Water Resources

If well telescopes please sketch and show depths.

GROUND LEVEL

155' 4"

370' 2"

X			

SECTION 19

Please indicate well location X.

ADDITIONAL INFORMATION

If more than one screen, show locations of each on sketch.