

PRiver  
02164

MISSISSIPPI DEPARTMENT OF NATURAL RESOURCES  
Bureau of Land and Water Resources  
Southport Mall  
P.O. Box 10631  
Jackson, Mississippi 39209  
WATER WELL DRILLERS LOG

10-20 19 92 Bud Penton Water Well Pearl River  
date well completed firm name county well located


LANDOWNER: Glen Taylor  
Rt 1 Box 256  
Carriere Ms 39426  
(mailing address)

description of formations encountered	from	to
Red clay	0	17
red sand	17	62

WELL LOCATION:  
sec. 13 T 4 N R 18 E  
S W  
miles in of Henley field  
(distance) (direction) (nearest town)

WELL PURPOSE: Home  
(home, irrigation, municipal, industrial)

- WELL COMPLETION DATA:
- (1) diameter (inches) 7
  - (2) total depth (feet) 62
  - (3) static water level (feet) 33 below top of ground.
  - (4) casing PVC, 52 (material), (depth)  
4" (size) If telescope see back.
  - (5) screen 10, 52 (length), (depth to top)  
4", PVC (size), (material)
  - (6) pump 1/2, 12 (HP), (yield gpm)  
electric (type power)
  - (7) electric log NO (yes or no)  
(organization running log)
  - (8) how well bottom plugged sandshark

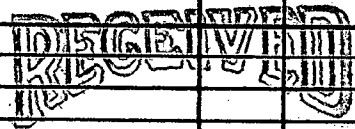

DEC 10 1992

Dept. of Environmental Quality  
Bureau of Land & Water Resources

DRILLERS REMARKS:

If well telescopes please sketch and show depths.

GROUND LEVEL

			X

SECTION 13

Please indicate well location X.

ADDITIONAL INFORMATION

If more than one screen,  
show locations of each on sketch.