

MISSISSIPPI DEPARTMENT OF NATURAL RESOURCES

Bureau of Land and Water Resources

Southport Mall

P.O. Box 10631

Jackson, Mississippi 39209

WATER WELL DRILLERS LOG

<u>P. River</u>
<u>Φ 2170</u>

2-3 1993 Bud Penton Water Well Serv. Pearl River
date well completed firm name county well located

LANDOWNER: Wayne Mitchell

127 Hobart Walker Rd

(mailing address)

description of formations encountered

from

to

red clay

0

17

red sand

17

72

WELL LOCATION:

sec. 23 T 4 N R 18 E
S W W
1/2 miles west of Henley Falls
(distance) (direction) (nearest town)

WELL PURPOSE: Home
(home, irrigation, municipal, industrial)

WELL COMPLETION DATA:

- (1) diameter (inches) 7
- (2) total depth (feet) 72
- (3) static water level (feet) 30 below above top of ground.
- (4) casing PVC 62
(material) (depth)
4 If telescope see back.
(size)
- (5) screen 10 62
(length) (depth to top)
4 PVC
(size) (material)
- (6) pump 1/2 18
(HP) (yield gpm)
elec
(type power)
- (7) electric log NO
(yes or no)
(organization running log)
- (8) how well bottom plugged sands/shale

DRILLERS REMARKS:


RECEIVED

MAY 06 1993

Dept. of Environmental Quality
Office of Land & Water Resources

If well telescopes please
sketch and show depths.

GROUND LEVEL

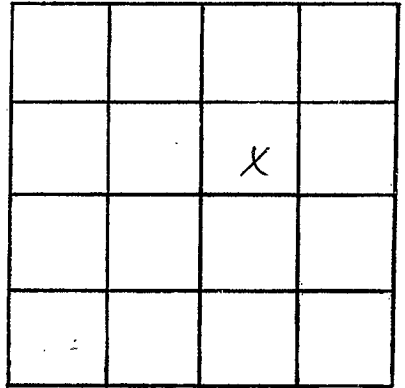

SECTION 23

Please indicate well location X.

ADDITIONAL INFORMATION

If more than one screen,
show locations of each on sketch.