

# MISSISSIPPI DEPARTMENT OF NATURAL RESOURCES

Bureau of Land and Water Resources

P.O. Box 10631

Jackson, Mississippi 39209

## WATER WELL DRILLERS LOG

COUNTY WELL LOCATED <b>PEARL RIVER</b>	
WELL NUMBER <b>0</b>	CODED
DATE WELL COMPLETED <b>3-23-94</b>	

PERMIT NUMBER
NAME OF DRILLING FIRM <b>Walker Well Service</b>

NAME & MAILING ADDRESS OF LANDOWNER <b>First Baptist Church Henry Field, Ms.</b>			
WELL LOCATION: SEC	TOWNSHIP	RANGE	
<b>14</b>	<b>A</b>	<b>N</b>	<b>18</b>
DISTANCE		DIRECTION	
_____ Miles		_____ of _____	
OTHER LANDMARK <b>Church</b>			
WELL PURPOSE: Home, Irrigation, Municipal, Industrial, Fish Pond, etc.			

PUMP DATA		
PUMP TYPE (Circle One): Submersible, Turbine, <input checked="" type="radio"/> Jet, Flowing Well, Other (Describe) <b>1 1/2" MSE</b>		
POWER TYPE (Circle One): <input checked="" type="radio"/> Electric, Tractor, Diesel, Gasoline, Butane, Other (Describe)		
Pump Capacity (GPM) <b>8 GPM</b>	No. of Stages	Setting Depth <b>60'</b> FT.
PUMP TEST		
Well yielded _____ GPM with a drawdown of _____ ft. after _____ hours of pumping		

WELL DATA		
Well Depth <b>64'</b>	Casing Diameter (In.) <b>2"</b>	Casing Length (FT.) <b>658</b>
Type of Casing	Hole Depth	Depth to Static Water Level
TYPE OF COMPLETION: (Circle One or More): Gravel Packed, Underreamed, Telescoped, Natural Development, Open Hole, Other (Describe) <b>Natural Development</b>		
Top of Lap Pipe or Reduction in Casing <b>FEET</b> IF TELESKOPED OR MORE THAN ONE SCREEN: USE BACK PAGE		

LOG DATA	
TYPE OF LOG RUN (Circle One): No Log Run, Electric, Gamma Ray, Density, Sonic, Neutron, Other (Describe)	
Name of Organization Running Log	

SCREEN DATA		
Diameter - Inches <b>2"</b>	Length - Feet <b>10'</b>	Slot Size - Inches <b>10</b>
Screen Type <b>PVC</b>	Depth to Bottom - Feet <b>58'</b>	


GEOLOGIC DATA (Office Use Only)			
Surface Elev.	Geologic Unit	Unit Thickness	Depth to Top
Subs. SWL	Date	Analysis	Aquifer Test
Driller's Remarks			

DESCRIPTION OF FORMATIONS ENCOUNTERED	FROM	TO	FORMATIONS (Continued)
<b>Clay</b>	<b>0'</b>	<b>30'</b>	<div style="border: 2px solid black; padding: 5px; display: inline-block;"> <b>PROCESSED</b>  <b>NOV 06 1995</b>                      Dept. of Environmental Quality                      Office of Land &amp; Water Resources                 </div>
<b>Gravel on top, red SAND, to pink SAND.</b>	<b>30'</b>	<b>68'</b>	

IF MORE SPACE IS NEEDED, USE BACK

If well telescopes please  
sketch and show depths.

GROUND LEVEL

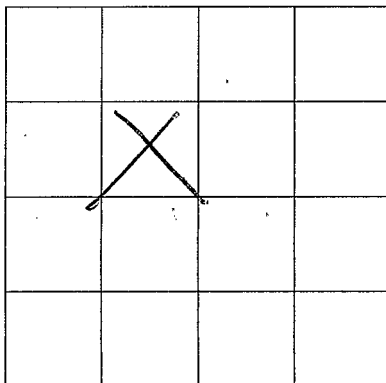

SECTION \_\_\_\_\_

Please indicate well location X.

ADDITIONAL INFORMATION

If more than one screen,  
show location of each on sketch.