

Pearl River  
 # 2181  
 10/75

MISSISSIPPI  
 BOARD OF WATER COMMISSIONERS  
 416 North State Street  
 Jackson, Mississippi 39201

WATER WELL DRILLERS LOG

Oct. 1975 E.B. Sheppard Pearl River  
 date well completed firm name county well located

LANDOWNER:  
Lemuel Seal  
Rt. 1, Carrier, Ms.  
 (mailing address)

description of fomations encountered	from	to
CLAY CLAY	0	15'
RED BISH CLAY	15	40'
SAND STREAKS	40	70'
SAND + DEA BR.	70	105'

WELL LOCATION:  
 sec 14 T 4 N R 18 E <sup>13V</sup>  
 (S) (W)  
12 miles NW of Pearl River  
 (distance) (direction) (nearest town)

WELL PURPOSE:  
 home irrigation, municipal, industrial

- WELL COMPLETION DATA:
- (1) diameter (inches) 2"
  - (2) total depth (feet) 105'
  - (3) static water level (feet) 45'  below  above top of ground.
  - (4) casing pl. 100'  
 (material) (depth)  
2" if telescope see back.  
 (size)
  - (5) screen 5'  
 (length) (depth to top)  
2" pl.  
 (size) (material)
  - (6) pump 1 7  
 (HP) (yield gpm)  
E  
 (type power)
  - (7) electric log (yes or no)
  - (organization running log)
  - (8) how well bottom plugged BWV


RECEIVED  
 MISSISSIPPI  
 DEC - 5 1975

MISS. BD. OF WATER COMM.

DRILLERS REMARKS:

If well telescopes please sketch and show depths.

GROUND LEVEL

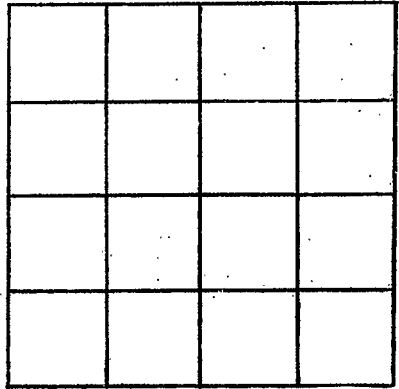

SECTION \_\_\_\_\_

Please indicate well location X.

ADDITIONAL INFORMATION

If more than one screen,  
show locations of each on sketch.