

MISSISSIPPI DEPARTMENT OF ENVIRONMENTAL QUALITY

Office of Land and Water Resources

P. O. Box 10631
Jackson, MS 39289-0631
WATER WELL DRILLERS LOG

COUNTY WELL LOCATED PEARL-RIVER	
WELL NUMBER 2192	CODED
DATE WELL COMPLETED 4-26-97	

PERMIT NUMBER 0519
NAME OF DRILLING FIRM BURGE WELL SERVICE

NAME & MAILING ADDRESS OF LANDOWNER DAVID Holloway			
330 HARRY SONES RD			
CARRIERO MS, 39426			
WELL LOCATION: SEC	TOWNSHIP	RANGE	
7	33	4	N 18 E
DISTANCE	DIRECTION	NEAREST TOWN	
2 Miles	S	of CARRIERO	
OTHER LANDMARK B-P STATION			
WELL PURPOSE (Circle one) Irrigation, Municipal, Industrial, Fish Pond, etc. Home			

PUMP DATA			
PUMP TYPE (Circle One): Submersible Turbine, Jet, Flowing Well, Other (Describe) _____			
POWER TYPE (Circle One): Electric Tractor, Diesel, Gasoline, Butane, Other (Describe) _____ H/P 1/2			
Pump Capacity (GPM)	No. of Stages	Setting Depth	
12	5	100 FT.	
PUMP TEST			
Well yielded _____ GPM with a drawdown of _____ ft. after _____ hours of pumping			

WELL DATA		
Well Depth 189	Casing Diameter (In.) 4	Casing Length (Ft.) 179
Type of Casing PVC	Hole Depth 190	Depth to Static Water Level 60
TYPE OF COMPLETION: (Circle One or More): Gravel Packed, Underreamed, Telescoped, Natural Development, Open Hole, Other (Describe) PUMPED		
WELL GROUTED TO A DEPTH OF 10 FEET Type Grout (circle one): Cement, Bentonite, or Mix		

LOG DATA	
TYPE OF LOG RUN (Circle One): No Log Run, Electric, Gamma Ray, Density, Sonic, Neutron, Other (Describe) _____	
Name of Organization Running Log	

SCREEN DATA		
Diameter - Inches 4	Length - Feet 10'	Slot Size - Inches 12
Screen Type SLOT	Depth to Bottom - Feet 189	

GEOLOGIC DATA (Office Use Only)			
Surface Elev.	Geologic Unit	Unit Thickness	Depth to Top
Subs. SWL	Date	Analysis	Aquifer Test


Driller's Remarks GRAB WELL	
Top of Lap Pipe or Reduction in Casing	
RECEIVED	
MAY 22 1997	

DESCRIPTION OF FORMATIONS ENCOUNTERED	FROM	TO	FORMATIONS (Continued)	FROM	TO
RED CLAY	0	15			
RED SAND	15	25			
PURPLE CLAY	25	65			
BLUE CLAY	65	120			
SAND	120	180			

Dept. of Environmental Quality
Office of Land & Water Resources

If well telescopes please sketch and show depths.

GROUND LEVEL

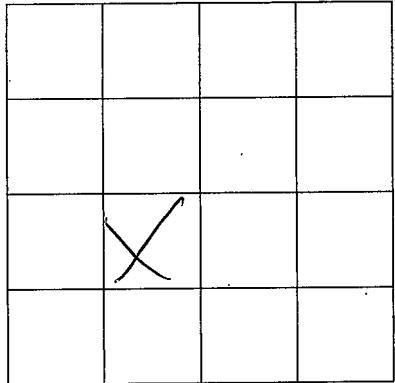

SECTION _____

Please indicate well location X.

ADDITIONAL INFORMATION

If more than one screen,
show location of each on sketch.