

MISSISSIPPI DEPARTMENT OF ENVIRONMENTAL QUALITY

Office of Land and Water Resources

P. O. Box 10631
Jackson, MS 39289-0631
WATER WELL DRILLERS LOG

COUNTY WELL LOCATED:
Pearl River

WELL NUMBER: 2193 CODED: 4

DATE WELL COMPLETED:
3-18-97

PERMIT NUMBER: D-477

NAME OF DRILLING FIRM:
Penton Well Serv.
Nicholson, MS.

NAME & MAILING ADDRESS OF LANDOWNER:
Mable Perry
52 Hobart Walker Rd.
Carriere, MS. 39436

WELL LOCATION: SEC 38 TOWNSHIP 4 RANGE 18
S W

DISTANCE 1 Miles DIRECTION 5 NEAREST TOWN Hexleyfield

OTHER LANDMARK

WELL PURPOSE: Home Irrigation, Municipal, Industrial, Fish Pond, etc.

PUMP DATA

PUMP TYPE (Circle One):
 Submersible, Turbine, Jet, Flowing Well,
Other (Describe) _____

POWER TYPE (Circle One):
 Electric, Tractor, Diesel, Gasoline, Butane,
Other (Describe) _____ H/P 1

Pump Capacity (GPM) 15 No. of Stages 9 Setting Depth 70 FT.

PUMP TEST

Well yielded _____ GPM with
a drawdown of _____ ft.
after _____ hours of pumping

WELL DATA

Well Depth 85' Casing Diameter (in.) 4 Casing Length (Ft.) 75

Type of Casing PVC Hole Depth 85 Depth to Static Water Level 30

LOG DATA

TYPE OF LOG RUN (Circle One):
Electric, Gamma Ray, Density, Sonic, Neutron, No Log Run,
Other (Describe) _____

Name of Organization Running Log _____

TYPE OF COMPLETION: (Circle One or More):
 Gravel Packed, Underreamed, Telescoped,
 Natural Development, Open Hole, Other

WELL GROUTED TO A DEPTH OF 10 FEET
Type Grout (circle one): Cement, Bentonite, or Mix

GEOLOGIC DATA (Office Use Only)

Surface Elev.	Geologic Unit	Unit Thickness	Depth to Top
Subs. SWL	Date	Analysis	Aquifer Test

SCREEN DATA

Diameter - Inches 4 Length - Feet 10 Slot Size - Inches 12

Screen Type PVC Depth to Bottom - Feet 75-85

Driller's Remarks

DESCRIPTION OF FORMATIONS ENCOUNTERED	FROM	TO
<u>Clay</u>	<u>0</u>	<u>25</u>
<u>Sand (Red)</u>	<u>25</u>	<u>85</u>

RECEIVED


JUN 26 1997

Dept. of Environmental Quality
Office of Land & Water Resources

IF MORE SPACE IS NEEDED, USE BACK

If well telescopes please sketch and show depths.

GROUND LEVEL

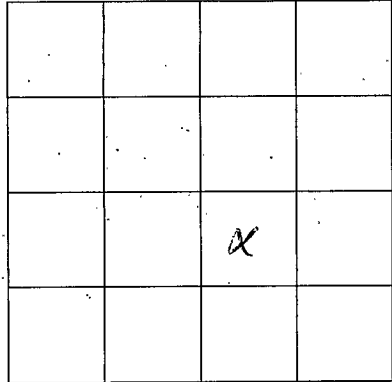

SECTION 38

Please indicate well location X.

ADDITIONAL INFORMATION

If more than one screen,
show location of each on sketch.