

Pearl River
P
8-29-75

MISSISSIPPI
 BOARD OF WATER COMMISSIONERS
 416 North State Street
 Jackson, Mississippi 39201

13V

WATER WELL DRILLERS LOG

8/29 1975 Bud Peters & Son Pearl River
 date well completed firm name county well located

LANDOWNER: Sandy Anderson

description of formations encountered	from	to
	<u>Red shale</u>	<u>0</u>
<u>Red sand</u>	<u>26</u>	<u>49</u>

B.T. 1 carrier
rights
 (mailing address)

WELL LOCATION:

sec 36 T 4 N R 17 E
 (S) (W)
4 miles East of N. Carrier
 (distance) (direction) (nearest town)

WELL PURPOSE: home
 (home, irrigation, municipal, industrial)

WELL COMPLETION DATA:


- diameter (inches) 4 1/2
 - total depth (feet) 45 ft
 - static water level (feet) 16 below top of ground. above
 - casing PVC, 49
 (material) (depth)
no if telescope see back.
 (size)
 - screen 1/2" x 10, 39
 (length) (depth to top)
no, PVC
 (size) (material)
 - pump 1/2, 600
 (HP) (yield gpm)
Elect
 (type power)
 - electric log no
 (yes or no)
- (organization running log)
- (8) how well bottom plugged no sand
sharp

DRILLERS REMARKS:

RECEIVED
 OCT 20 1975

If well telescopes please sketch and show depths.

GROUND LEVEL

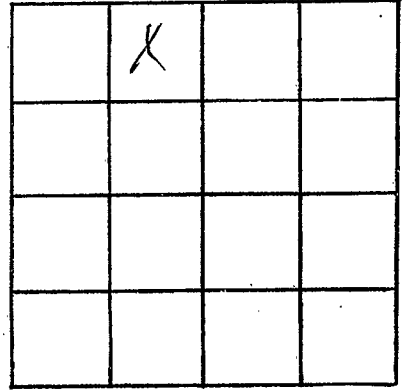

SECTION _____

Please indicate well location X.

ADDITIONAL INFORMATION

If more than one screen, show locations of each on sketch.