

Pearl River
 P4
 5-20-69

MISSISSIPPI
 BOARD OF WATER COMMISSIONERS
 416 North State Street
 Jackson, Mississippi 39201

WATER WELL DRILLERS LOG

5-20 1969 date well completed
 E. S. Warner Well Sd. firm name
 Pearl River county well located

LANDOWNER: Habarta-Pentton
McNeil Miss.
 (mailing address)

description of formations encountered	from	to
Red surface clay	0	30
Coarse white sand gravel	30	60
white clay	60	80
Blue soft clay	80	210
Coarse gray sand gravel	210	234

WELL LOCATION:
 sec. 25 T. 4 N. R. 17 E.
Se W
3 miles west of McNeil
 (distance) (direction) (nearest town)

WELL PURPOSE: Home
 (home, irrigation, municipal, industrial)

WELL COMPLETION DATA:


- (1) diameter (inches) 4 1/2
- (2) total depth (feet) 234
- (3) static water level (feet) 190 below/above top of ground.
- (4) casing Galv. (material), 234 (depth)
2 (size) if telescope see back.
- (5) screen 5' (length), 234-229 (depth to top)
2" (size), 5-Steel (material)
- (6) pump 2 (HP), 400 (yield gpm)
Elect (type power)
- (7) electric log NO (yes or no)
 (organization running log)
- (8) how well bottom plugged Shoe

MAY 28 1969
 MISS. BD. OF WATER COMMISSIONERS
 WATER CL.

DRILLERS REMARKS:
E. S. Warner

If well telescopes please sketch and show depths.

GROUND LEVEL

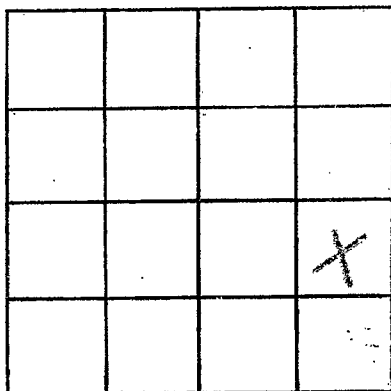

SECTION 25

Please indicate well location X.

ADDITIONAL INFORMATION

If more than one screen, show locations of each on sketch.