

Pearl River
 P 6
 11-22-69

MISSISSIPPI
 BOARD OF WATER COMMISSIONERS
 416 North State Street
 Jackson, Mississippi 39201

CODED
 CODED

WATER WELL DRILLERS LOG

11-22-69 date well completed
 1969 E. J. Worfer well serv Pearl River county well located
 firm name

LANDOWNER: Virgil Spiers

description of formations encountered	from	to
	whites Red clay	0
Blue clay	32	181
Coarse Gyp sd.	181	215

Rt 1 Carriere miss.
 (mailing address)

WELL LOCATION:
 sec. 33 T. 4 N. R. 16 E
3 miles West of McNeil
 (distance) (direction) (nearest town)

WELL PURPOSE: Home
 (home, irrigation, municipal, industrial)

- WELL COMPLETION DATA:
- (1) diameter (inches) 4.5
 - (2) total depth (feet) 215
 - (3) static water level (feet) 68' below top of ground.
 - (4) casing 2" G. O. B. 210
 (material) (depth)
2" if telescope see back.
 (size)
 - (5) screen 5' 215-210
 (length) (depth to top)
2" 5.5
 (size) (material)
 - (6) pump 1 310
 (HP) (yield gpm)
Ekrot
 (type power)
 - (7) electric log NO
 (yes or no)

(organization running log)
 (8) how well bottom plugged Shoe


DEC 18 1969

MISS. BD. OF
 WATER COMM.

DRILLERS REMARKS:

If well telescopes please sketch and show depths.

GROUND LEVEL

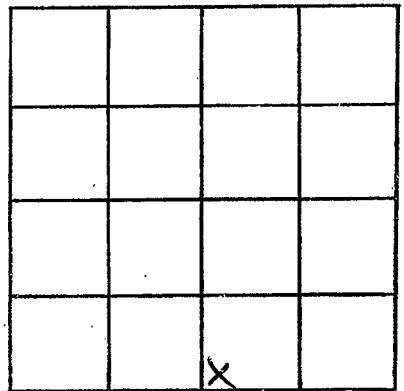

SECTION 33

Please indicate well location X.

ADDITIONAL INFORMATION

If more than one screen, show locations of each on sketch.