

MISSISSIPPI
BOARD OF WATER COMMISSIONERS
416 North State Street
Jackson, Mississippi 39201

CODED

WATER WELL DRILLERS LOG

Pearl River
P 8
2-24-70

2-24 19 70 Penton Well Serv Pearl River
date well completed firm name county well located

LANDOWNER: Amel Spiers
Rt. 1
Carriere Miss
(mailing address)

description of formations encountered	from	to
<u>Red clay</u>	<u>0</u>	<u>38</u>
<u>Red sand</u>	<u>38</u>	<u>85</u>
<u>White clay</u>	<u>85</u>	<u>120</u>
<u>Blue clay</u>	<u>120</u>	<u>272</u>
<u>Cerey sand</u>	<u>272</u>	<u>304</u>

WELL LOCATION:
sec. 19 T 4 S R 17 E
3 miles West of Mill Creek
(distance) (direction) (nearest town)

CODED

WELL PURPOSE: Home
(home, irrigation, municipal, industrial)

WELL COMPLETION DATA: 4 1/2

(1) diameter (inches) 2"

(2) total depth (feet) 304

(3) static water level (feet) 153 ^{below} ~~above~~ top of ground.

(4) casing Galv 299
(material) (depth)
2" if telescope see back.
(size)

(5) screen 5' 299
(length) (depth to top)

dia 2" St. Steel
(size) (material)

(6) pump B 5
(HP) (yield gpm)

Elec
(type power)

(7) electric log NO
(yes or no)

(organization running log)

(8) how well bottom plugged B.W. Value


MAR 12 1970

DRILLERS REMARKS:

MISS. BD. OF
WATER COMM.

If well telescopes please sketch and show depths.

GROUND LEVEL

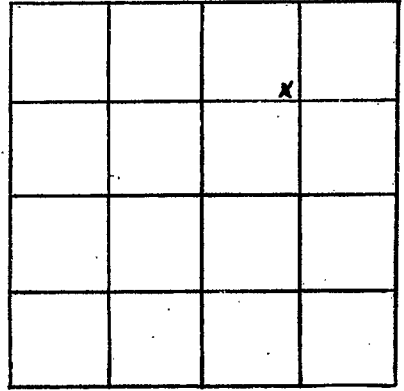

SECTION 19

Please indicate well location X.

ADDITIONAL INFORMATION

If more than one screen, show locations of each on sketch.