

Pearl River
P9
3-28-70

MISSISSIPPI
BOARD OF WATER COMMISSIONERS
416 North State Street
Jackson, Mississippi 39201

CODED

WATER WELL DRILLERS LOG

NEIL LUMPKIN WELL DRILLING SERVICE

P. O. BOX 117

OSHTOBI, MISS.

Pearl River

3-28 1970
date well completed

county well located

LANDOWNER: James F. Jackson
Paplarville
Route
(mailing address)

WELL LOCATION:
sec. 34 T. 4 R. 17
8 miles NW of Pearl River
(distance) (direction) (nearest town)

WELL PURPOSE: dwelling
(home, irrigation, municipal, industrial)

- WELL COMPLETION DATA:
- diameter (inches) 2"
 - total depth (feet) 237
 - static water level (feet) 41 below above top of ground.
 - casing galv (material) (depth) 2" if telescope see back. (size)
 - screen 5' (length) (depth to top) 2" St. Steel (size) (material)
 - pump 3/4 500 gph. (HP) (yield gpm) electric (type power)
 - electric log NO (yes or no)

(organization running log)

(8) how well bottom plugged Johnson
check pressure valve

DRILLERS REMARKS:

description of formations encountered	from	to
yellow clay	0	10
surface sand no 9009	10	30
white clay	30	80
sand, murky-brownish	80	110
blue clay	110	200
good sand	200	237


CODED

APR 13 1970

MISS. BD. OF
WATER COMM.

If well telescopes please sketch and show depths.

GROUND LEVEL

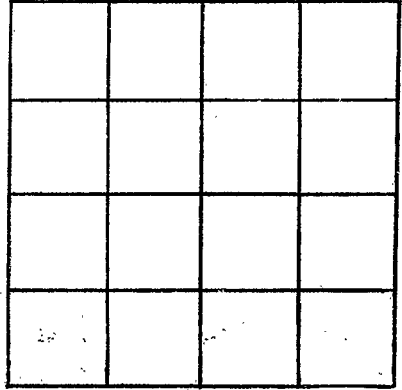

SECTION _____

Please indicate well location X.

ADDITIONAL INFORMATION

If more than one screen, show locations of each on sketch.